


# T. 36 S. R. 14 W. W.M.

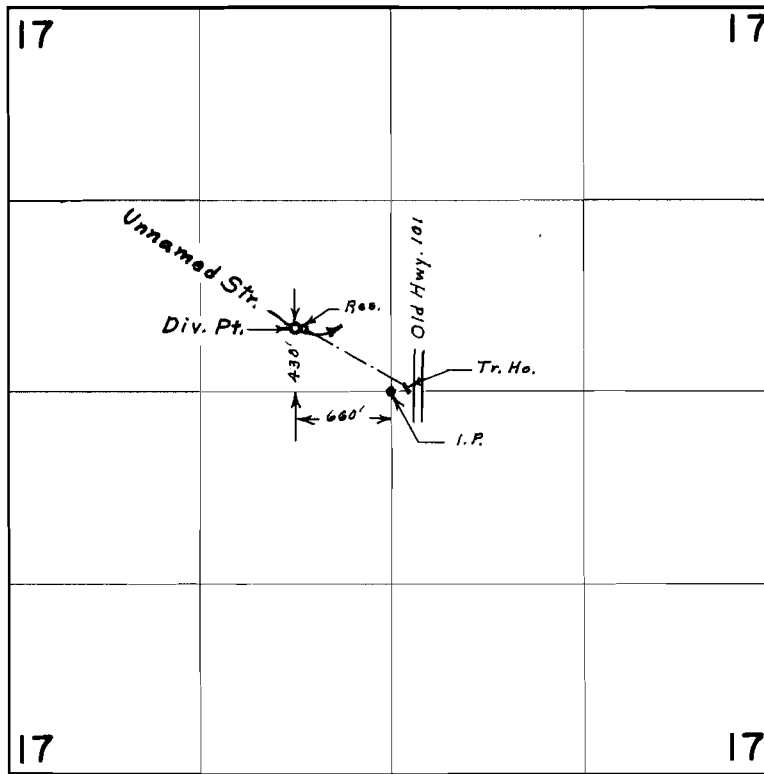

## FINAL PROOF SURVEY UNDER

Application No. 40067 Permit No. 29862  
IN NAME OF

VERNE L. LISTER

Surveyed Aug. 21, 1969, by L. E. Gould