


# T. 36 & 37 S. R. 14 & 15 W. W.M.

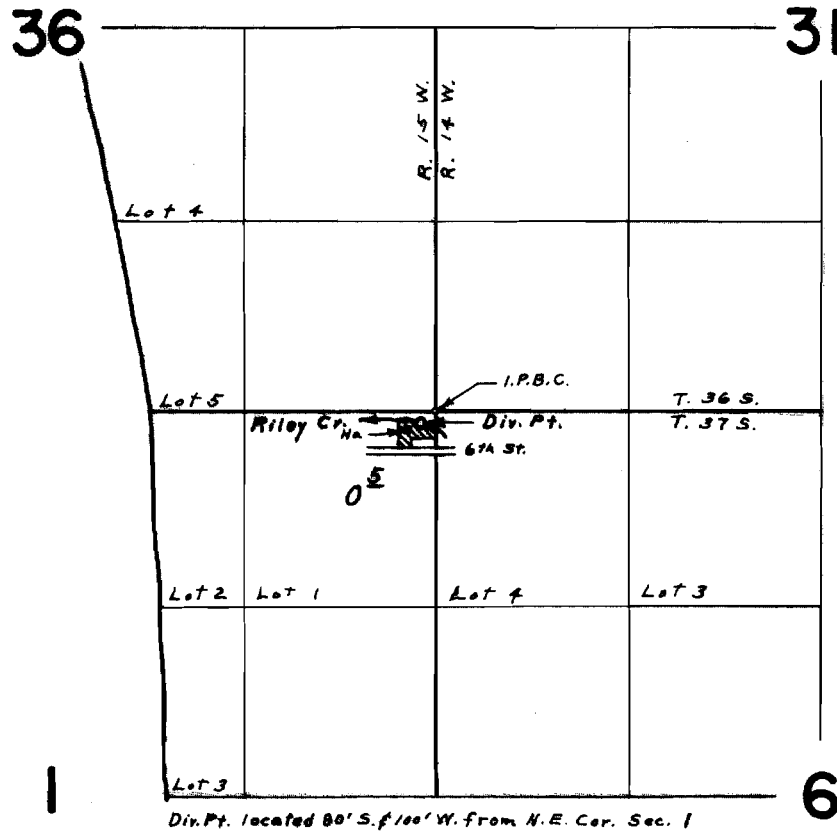

## FINAL PROOF SURVEY UNDER

Application No. 41796... Permit No. 31287...  
IN NAME OF

**CHARLES C. & HATTIE E. HOGUE**

Surveyed Aug. 21, 1969, by L. E. Gould...