


T. 34 S. R. 14 W. W. M.

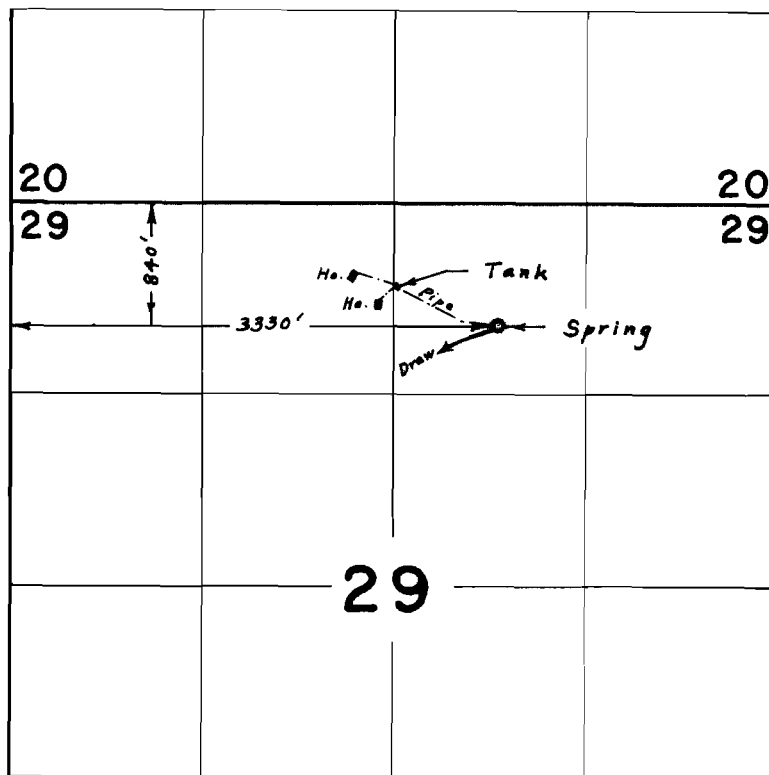

FINAL PROOF SURVEY
UNDER

Application No. 41920 Permit No. 31379
IN NAME OF

MARVIN C. & SHERON E. ZUBER

Surveyed Aug. 19, 1969, by L. E. Gould