


T. 28 S. R. 5 W. W.M..

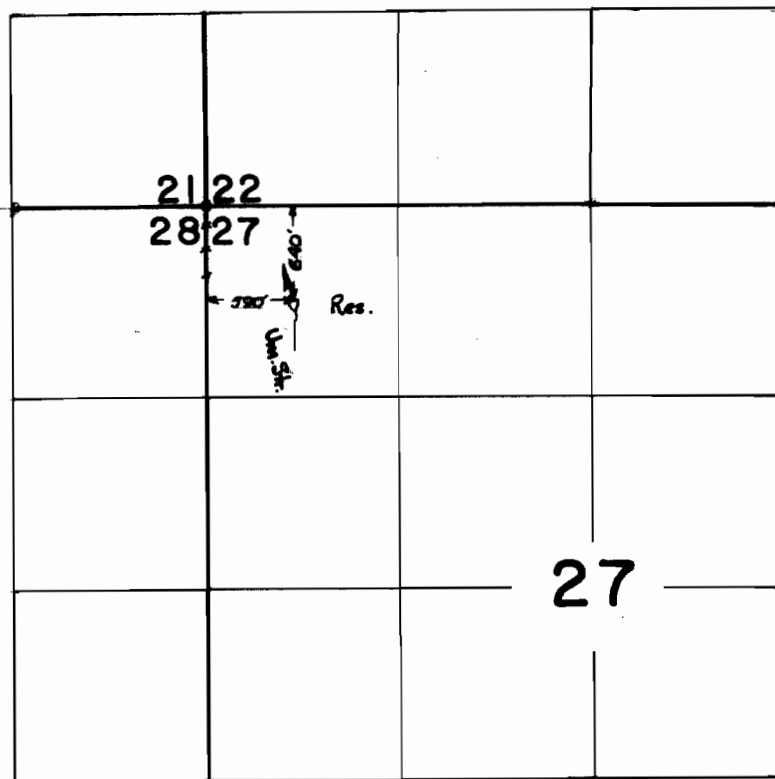

FINAL PROOF SURVEY
UNDER

Application No. R. 42572 Permit No. R. 4856
IN NAME OF

J. V. LONG

Surveyed 11 SEPT. 1969, by W. J. RUPPERT