


T.26 S.R.4W.W.M.

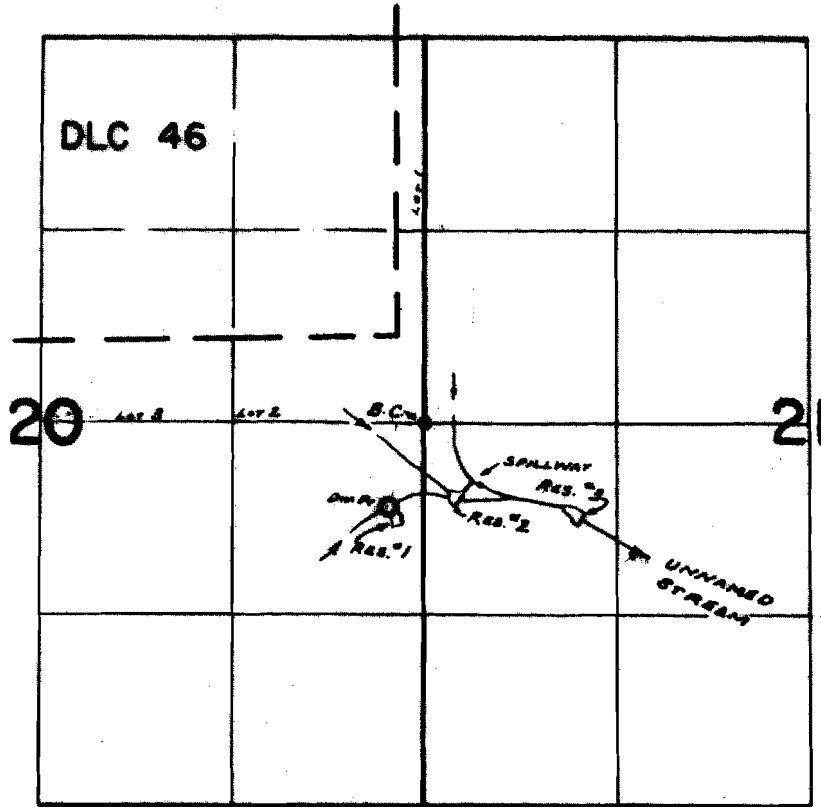


FINAL PROOF SURVEY
UNDER

Application No. ~~R-5000~~ Permit No. ~~R-5005~~
IN NAME OF

WAYNE D. MOSHER

Surveyed APR. 14, 1967, by W. RUPPERT

T.26 S.R.4W.W.M.

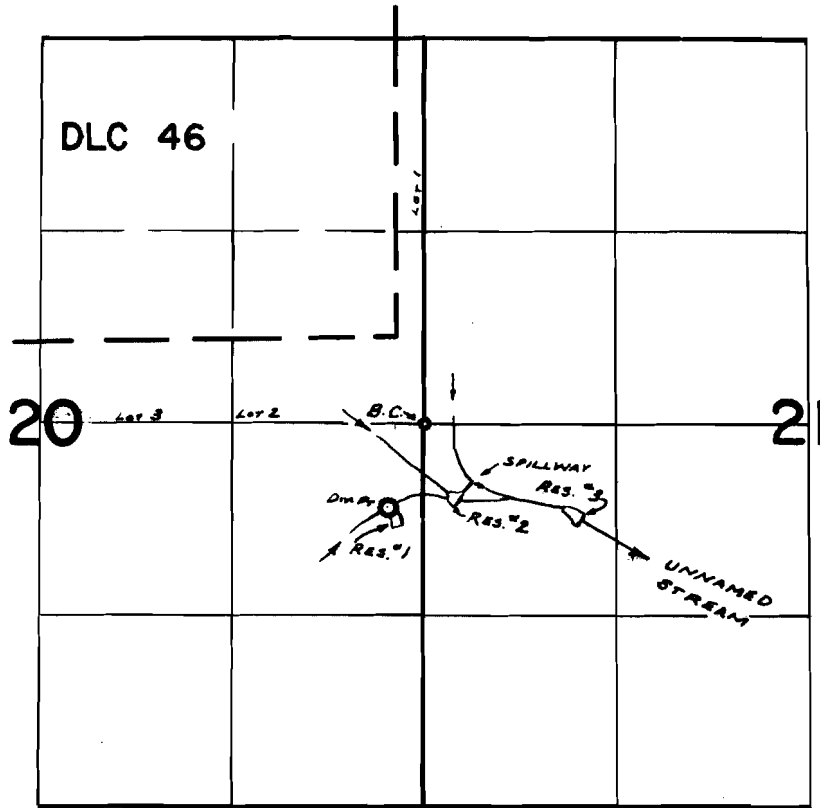

FINAL PROOF SURVEY UNDER

Application No. R-13005 Permit No. R-3085
IN NAME OF

WAYNE D. MOSHER

Surveyed APR. 14, 1969, by W. RUPPERT