


T. 23 S. R. 5 W. W.M.

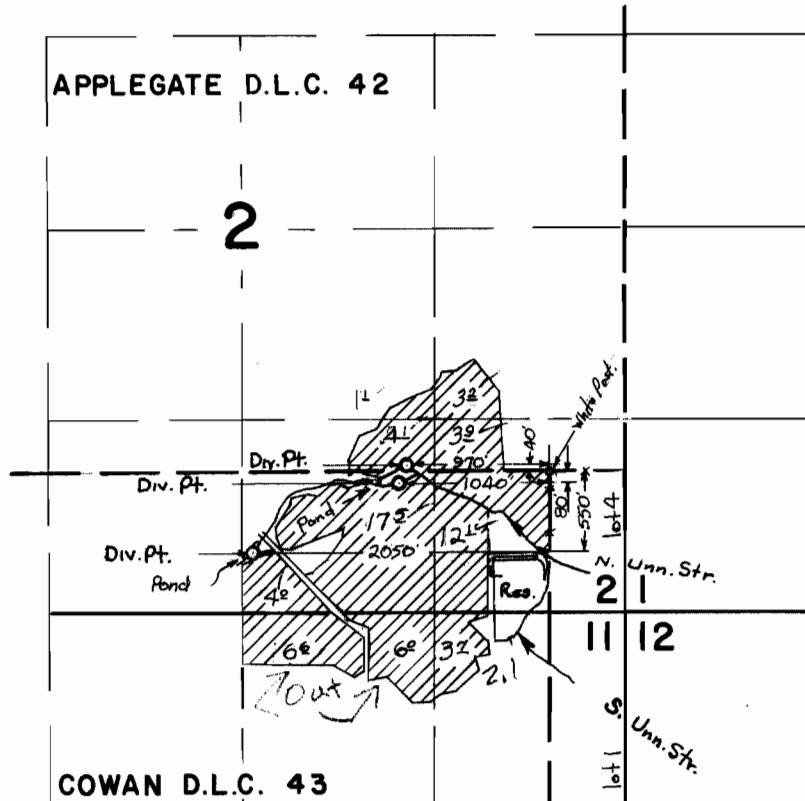

*S. Unn. Str. Div. Pt. located 730's. & 400' W. from
N.E. Cor. Cowan D.L.C. 43*

FINAL PROOF SURVEY
UNDER

R 40630 R 4553
Application No. 39156 Permit No. 30258
IN NAME OF

DARE & ANNA KINGERY

Surveyed 10-11 JULY 1969, by W. J. RUPPERT