


T. 23 S. R. 5 W. W.M.

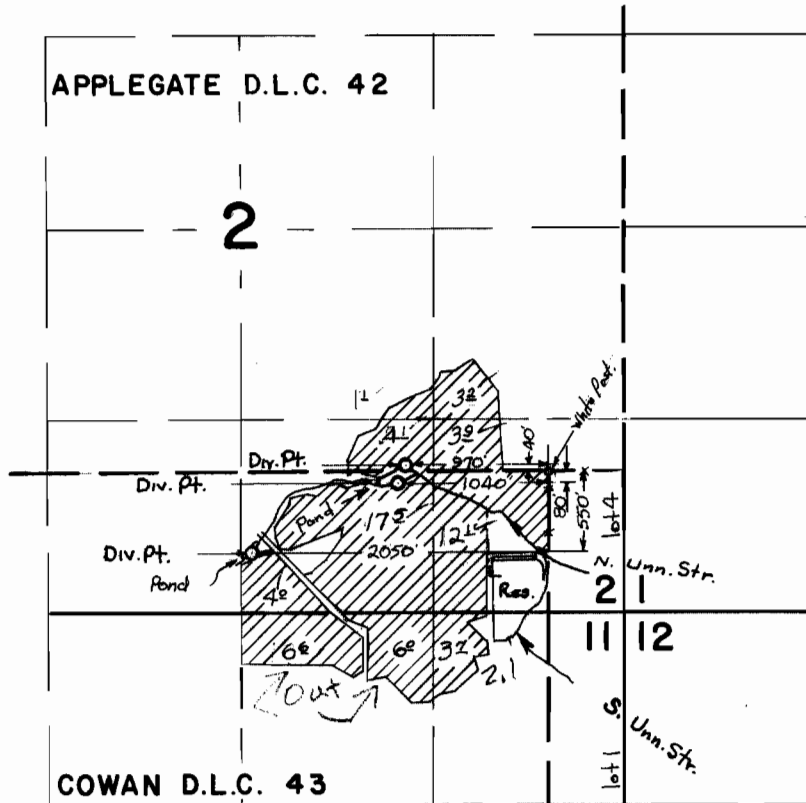

S. Unn. Str. Div. Pt. located 730's. & 400' W. from
N.E. Cor. Cowan D.L.C. 43

FINAL PROOF SURVEY

UNDER

Application No. **R 40630** Permit No. **R 4553**
39156 **30258**
 IN NAME OF

DARE & ANNA KINGERY

Surveyed 10-11 JULY 1969, by W.J. RUPPERT