T. 30 S. R. 4 W. W. M.

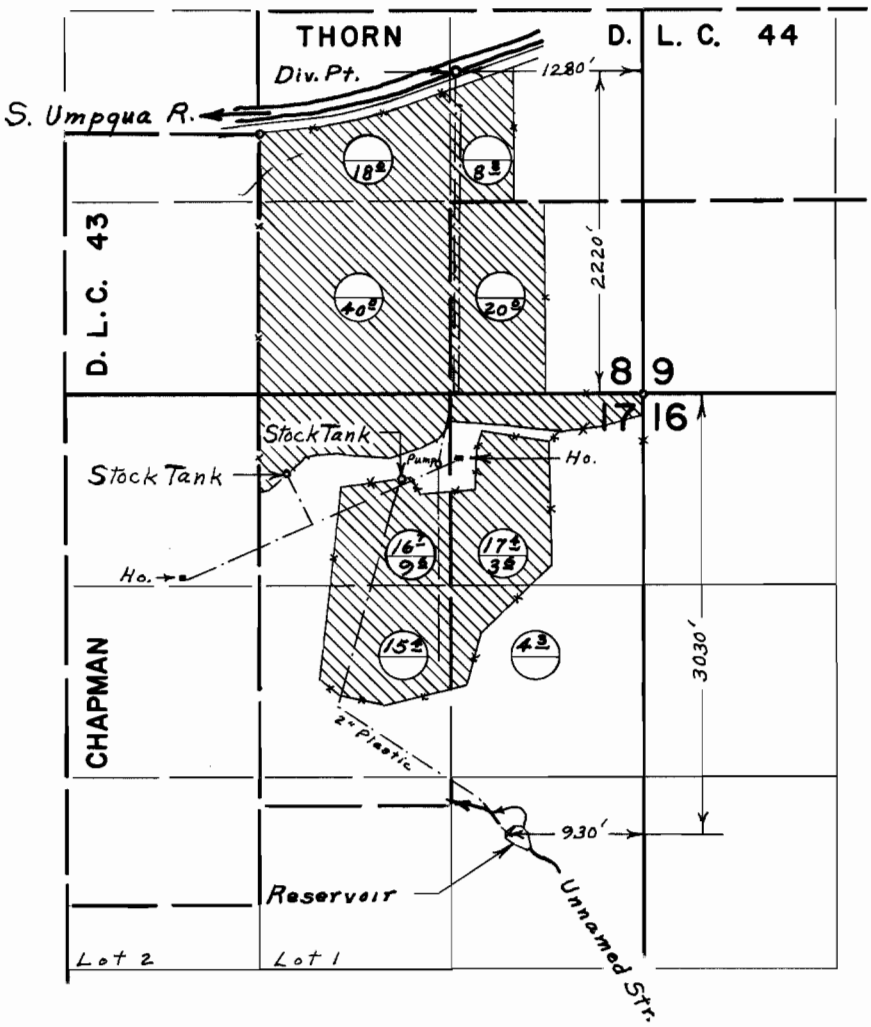

Primary
Supplemental

FINAL PROOF SURVEY

UNDER

41146 R-42801 Application No. 42802 Permit No. 30726 R-4753 31275

IN NAME OF

GREEN VALLEY FARMS

Surveyed June 24, 1969, by L. E. Gould

1969-U