T. 30 S. R. 4 W. W. M.

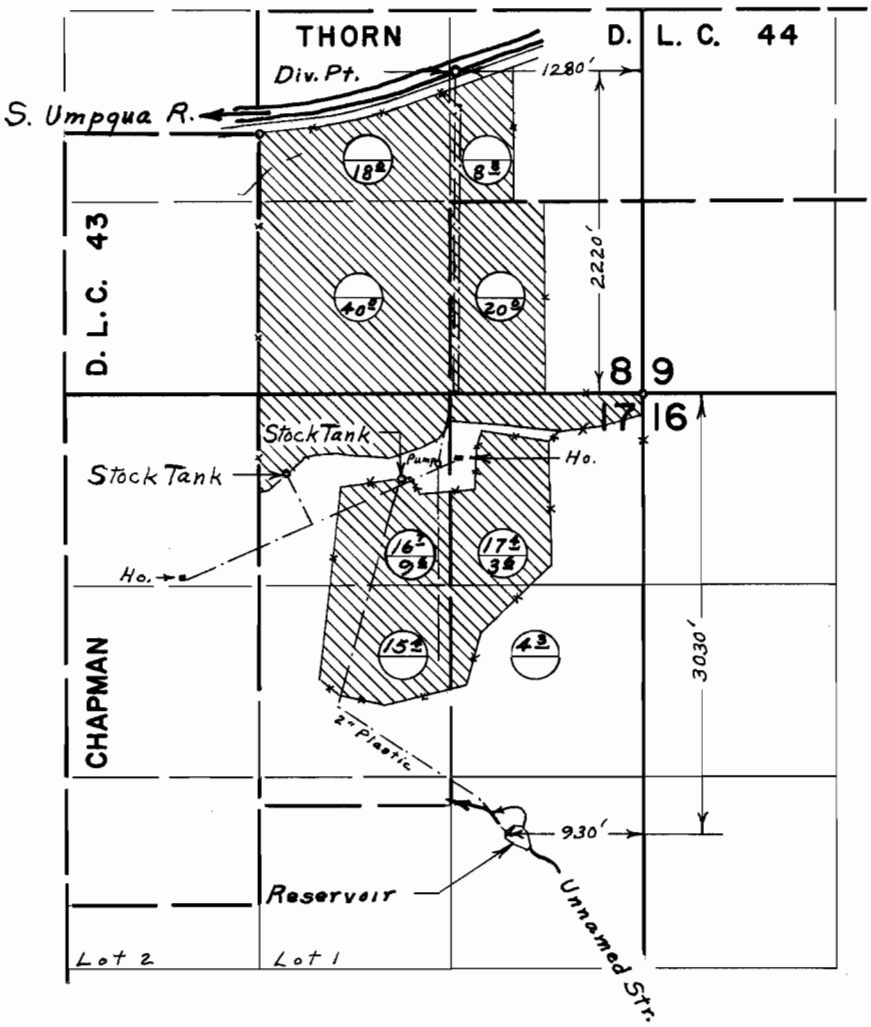

Primary
Supplemental

FINAL PROOF SURVEY
UNDER

41146 30726
R-42801 R-4753
Application No. 42802 Permit No. 31275
IN NAME OF

GREEN VALLEY FARMS

Surveyed June 24, 1969, by L. E. Gould

1969-U