


T. 28 S. R. 6 W. W.M.

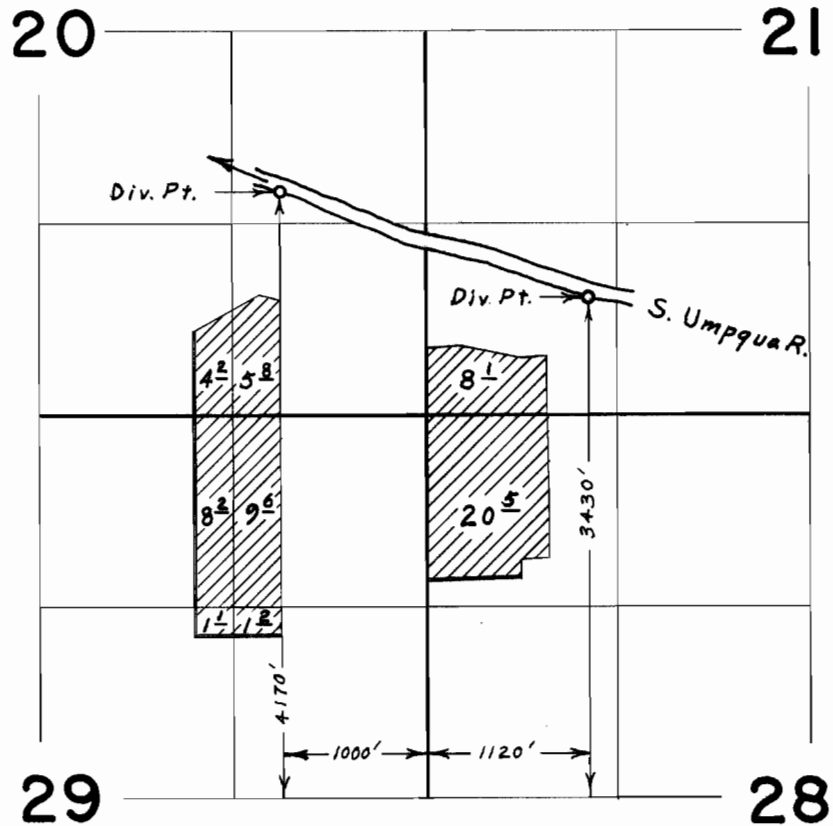

FINAL PROOF SURVEY UNDER

Application No. 38416 Permit No. 28612
IN NAME OF

FRED BURKS

Surveyed Sept. 12, 1969, by W. J. Ruppert