


T. 29 S. R. 8 W. W.M.

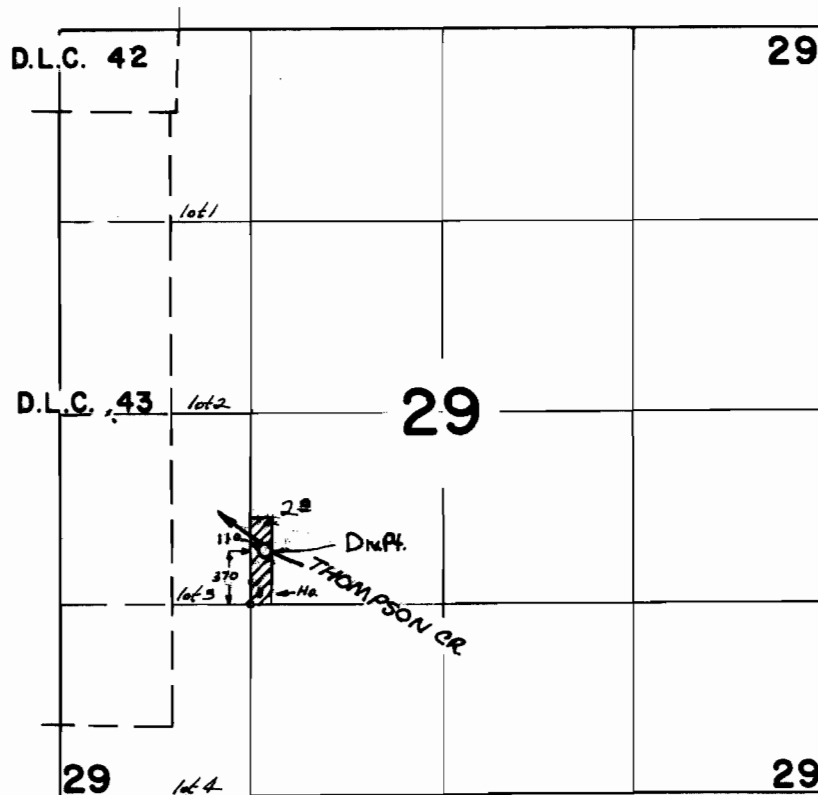

FINAL PROOF SURVEY UNDER

Application No. 40418 Permit No. 30134
IN NAME OF

WILLIAM SCHMIDT

Surveyed 10 SEPT. 1969, by W. J. RUPPERT