


T. 33 S. R. 7 W. W. M.

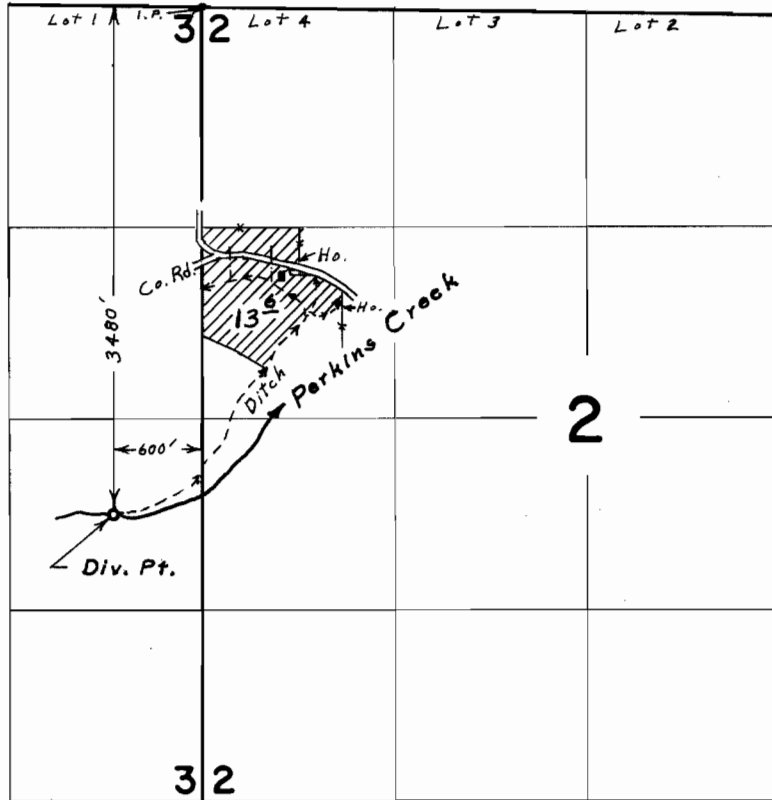

FINAL PROOF SURVEY UNDER

Application No. 40427 Permit No. 30210
IN NAME OF

HURSHEL L. FOSTER

Surveyed May 1, 1969, by L. E. Gould