


T.26S.R.3W.W.M.

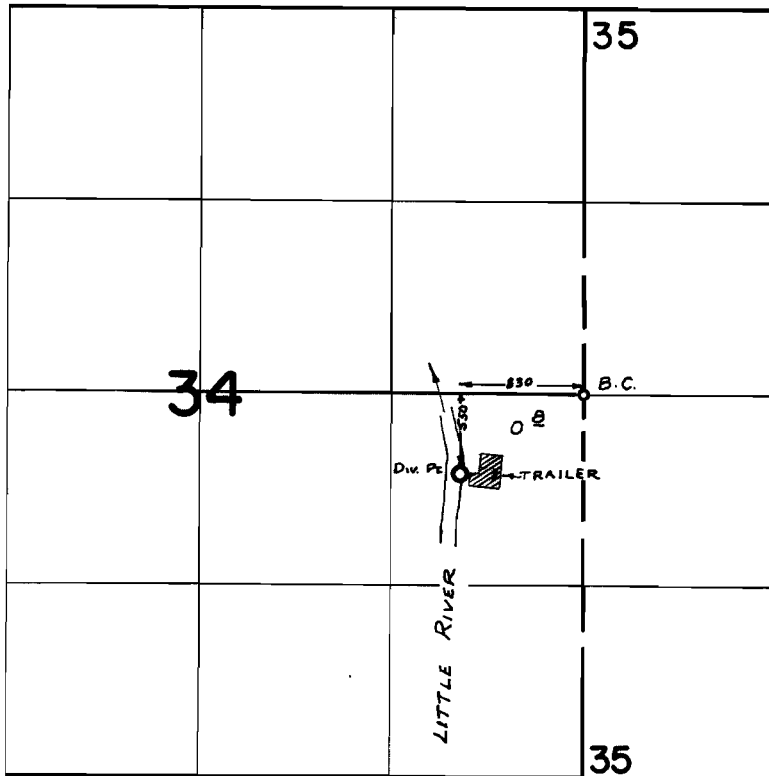

**FINAL PROOF SURVEY**  
UNDER

Application No. 41057..... Permit No. 30593.....  
IN NAME OF

E. J. & EDLA L. ANDERSON

Surveyed APR. 16., 19.69., by W. RUPPERT.....