


T. 29 S. R. 5 W. W.M.

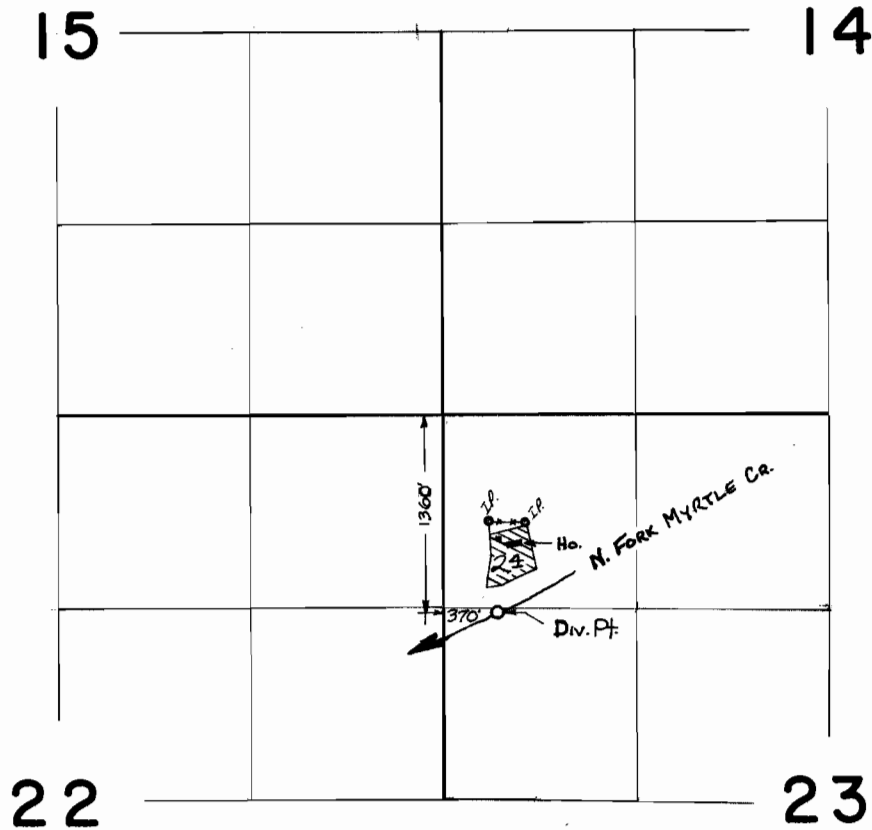

FINAL PROOF SURVEY
UNDER

Application No. 41666... Permit No. 31093...
IN NAME OF

HENRY H. & DORIS M. MOORE

Surveyed 11 SEPT. 1969, by W. J. RUPPERT.