


T. 29 S. R. 5 W. W. M.

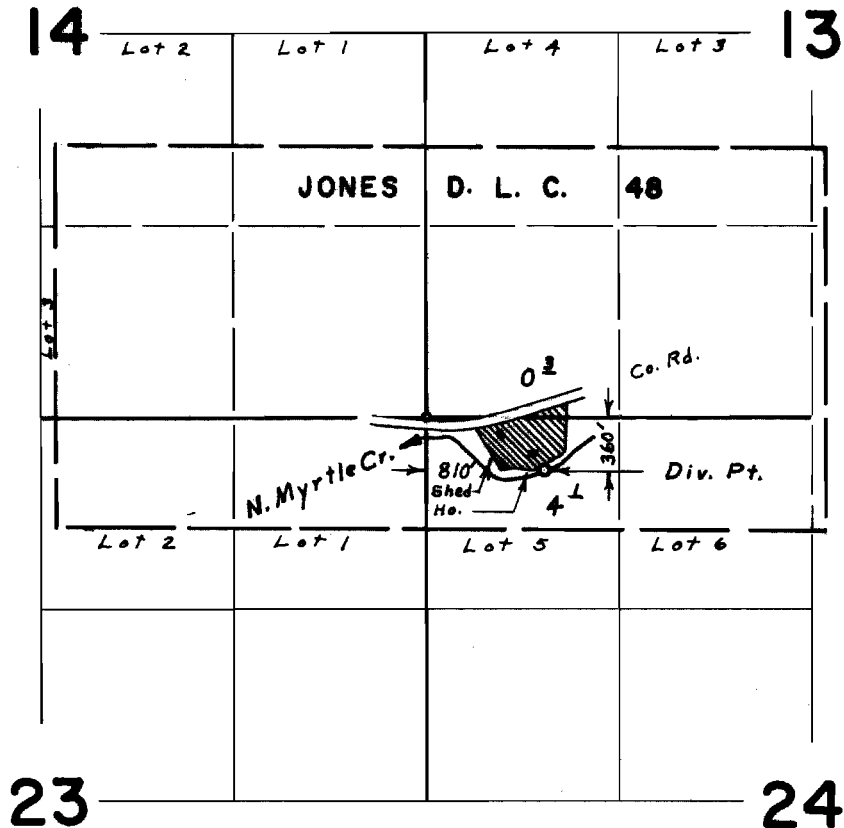

FINAL PROOF SURVEY
UNDER

Application No. 42178 Permit No. 31563
IN NAME OF

E. H. &/OR EDITH M. STEVENSON

Surveyed Aug. 7, 1969 by L. E. Gould