


T. 29 S. R. 5 W. W. M.

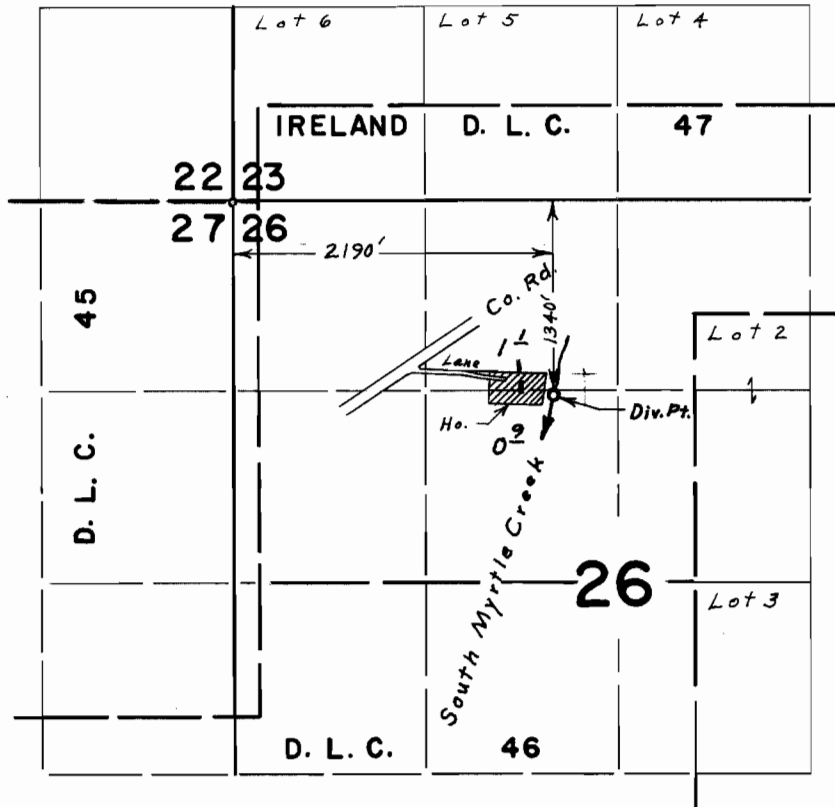

FINAL PROOF SURVEY UNDER

Application No. 42238 Permit No. 31608
IN NAME OF

BERTRAM H. & LOUISE E. FIDDY

Surveyed Aug. 7, 1969, by L. E. Gould