


T.22S.R.8W.W.M.

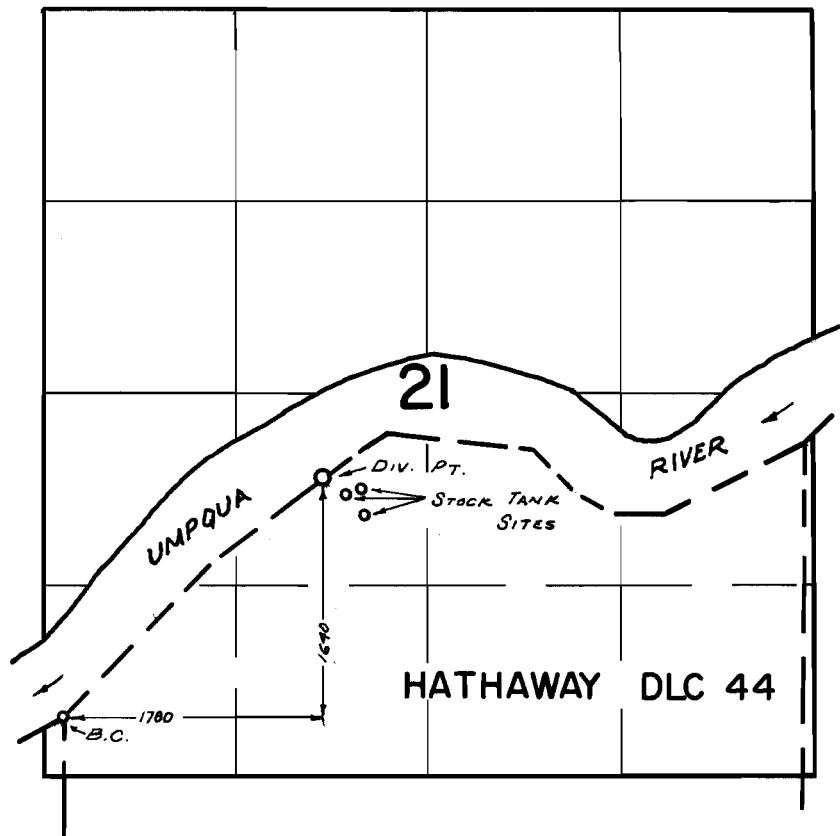

FINAL PROOF SURVEY
UNDER

Application No. 42323 Permit No. 31642
IN NAME OF

EUGENIA & CHARLEY SWEARINGEN

Surveyed JULY 8, 1969, by W. RUPPERT