


T. 30 S. R. 4 W. W.M.

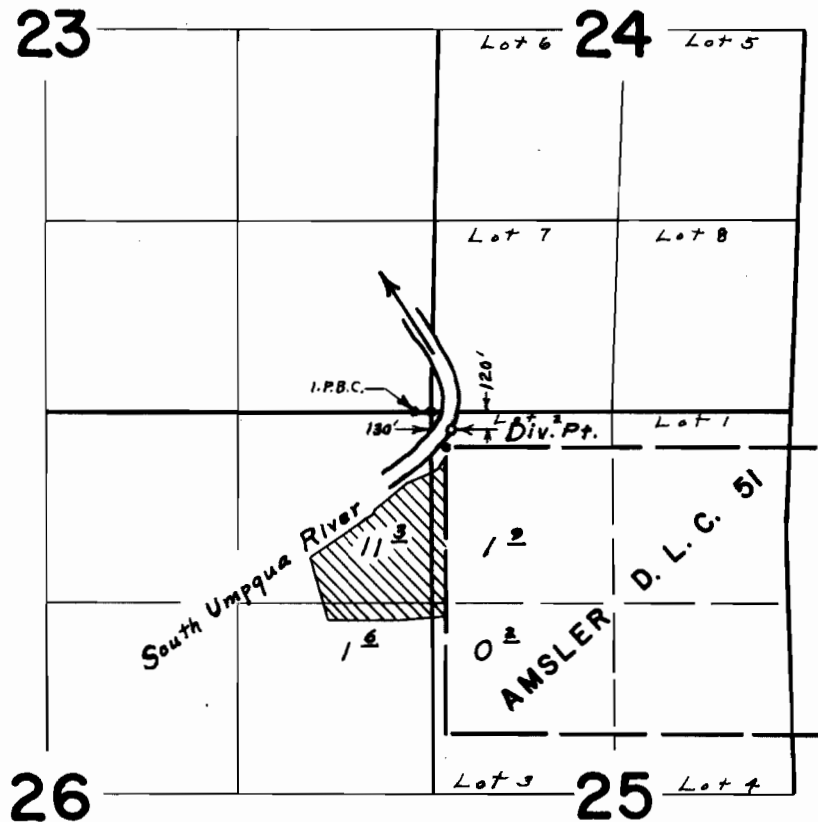

FINAL PROOF SURVEY
UNDER

Application No. 43060 Permit No. 32173
IN NAME OF
ROBERT D. CONLEY

Surveyed June 26, 1969, by L. E. Gould