


# T. 32 S. R. 5 W. W.M.

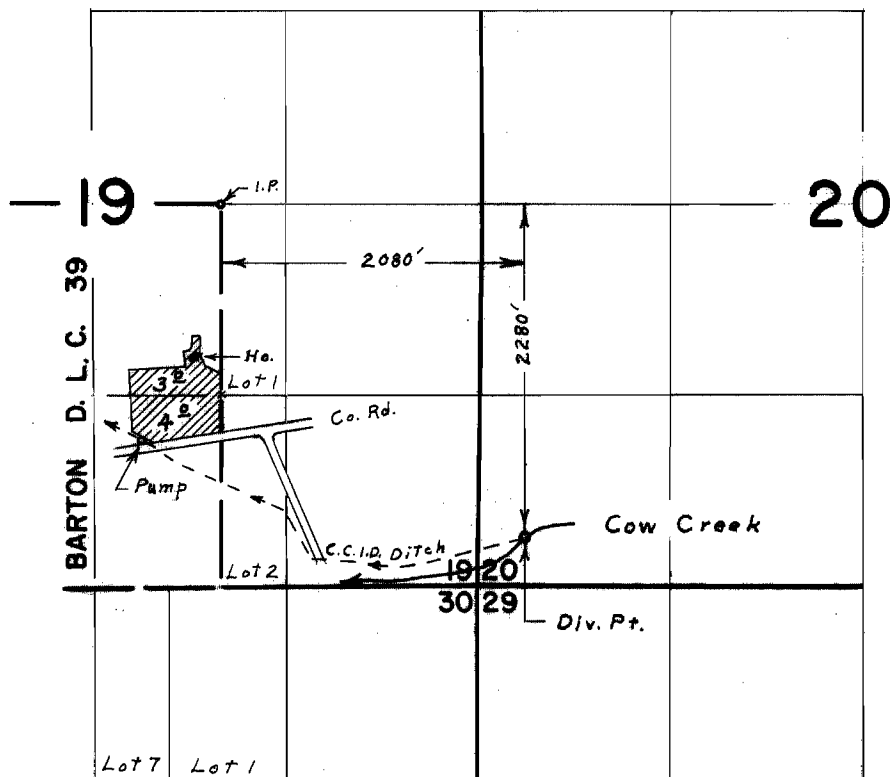

## FINAL PROOF SURVEY UNDER

Application No. 43720 Permit No. 32680  
IN NAME OF

KARL C. PAYNE

Surveyed July 29, 1969, by L. E. Gould.