


T. 30 S. R. 2 & 3 W. W.M.

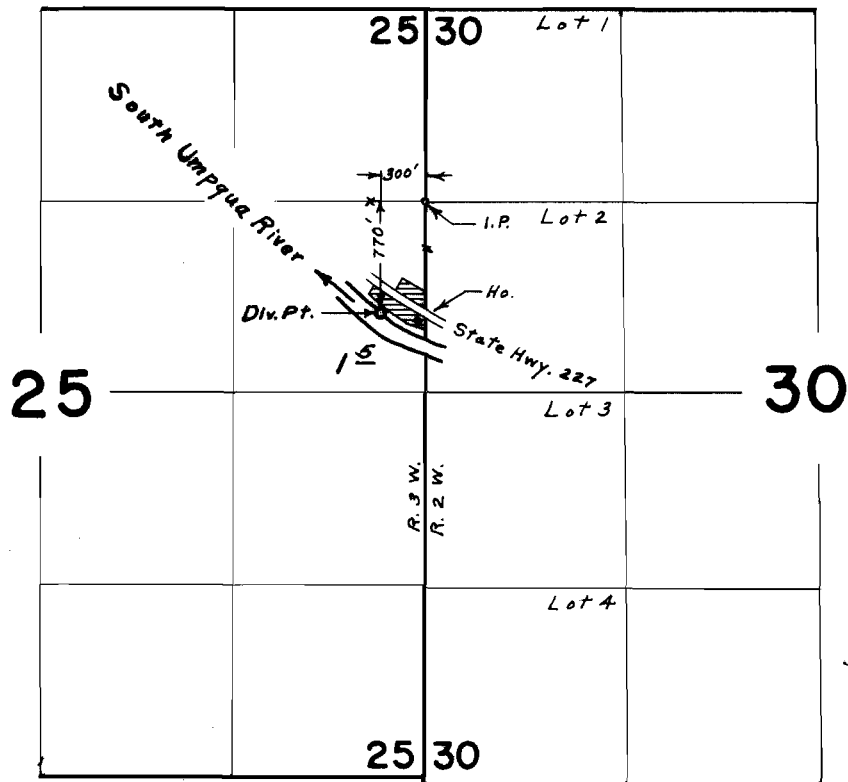

FINAL PROOF SURVEY
UNDER

Application No. 44032 Permit No. 32910
IN NAME OF

JAMES E. & REVA L. HARMON

Surveyed June 27, 1969, by L. E. Gould