


T.26 S.R.3W.W.M.

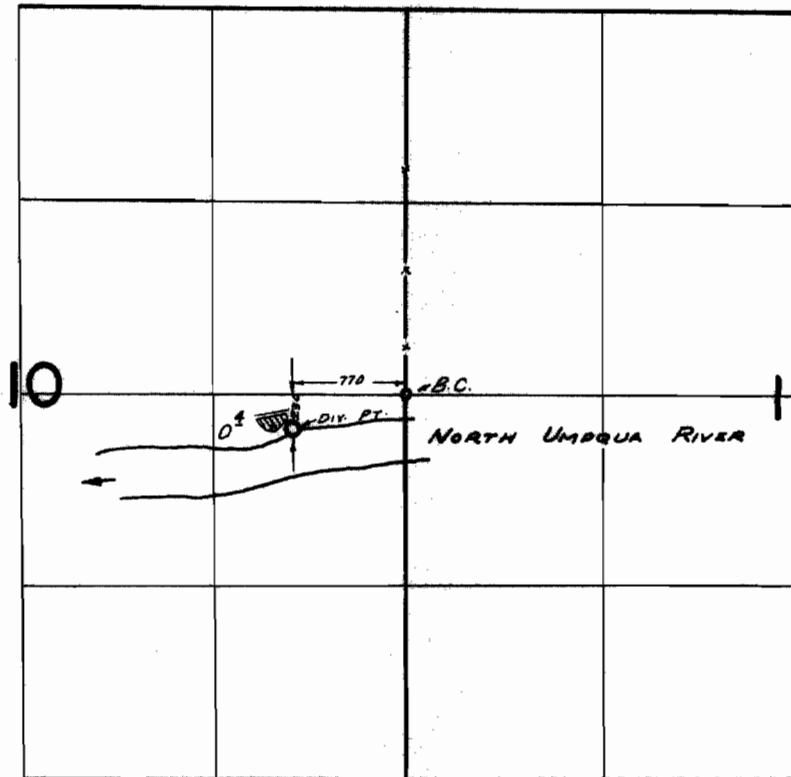

FINAL PROOF SURVEY
UNDER

Application No. 44900 Permit No. 33571
IN NAME OF

WILLIAM F. FORREST, JR.

Surveyed APR. 18, 1969, by W. BURBART