


P 28531
37118

T.10S. R.27E.W.M

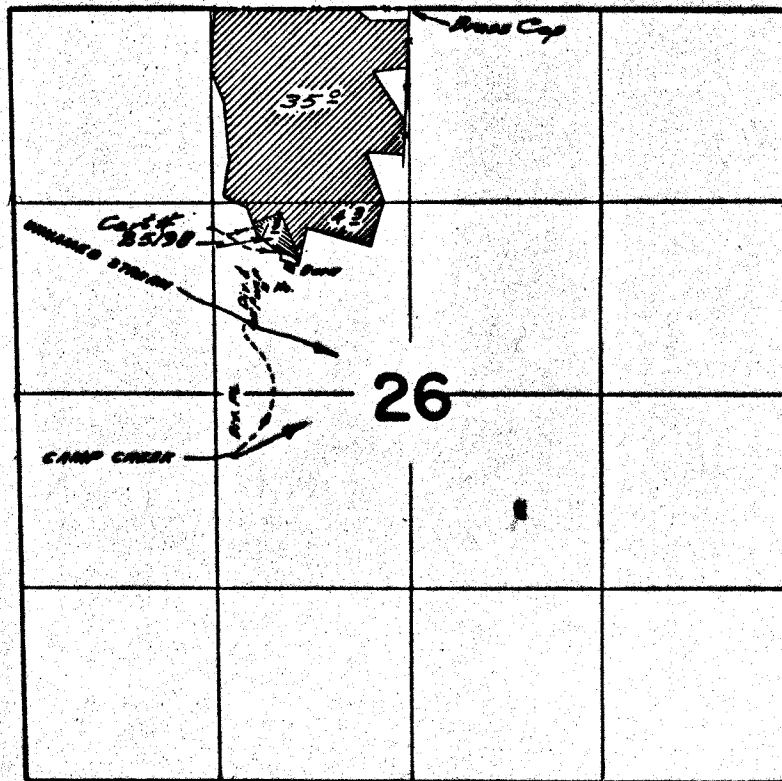

Diversion point from Unnamed Stream located E170 N55° 1080 M. W.
Diversion point from Camp Creek located S030 N55° 1190 M. W.
Both from North 1/4 Corner Section 26.



PRIMARY PERMIT 28531

ALL SUPPLEMENTAL
PERMIT 29100

FINAL PROOF SURVEY UNDER

38323 28531
Application No. 3908.8 Permit No. 29100
IN NAME OF

FLOYD A. VAUGHAN

Surveyed May 23 1968, by W. J. Ruggert