


P 29100
37119

T.10S. R.27E.WM

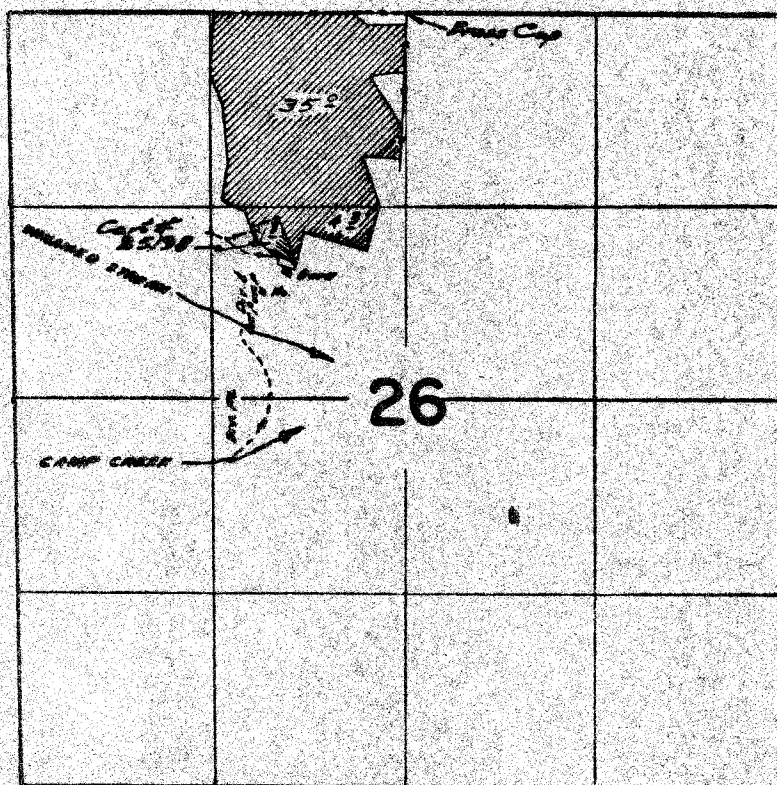

Diversion point from Warmed Stream Located 2170 N.E. & 1060 W.E.
Diversion point from Camp Creek Located 2030 N.E. & 1190 W.E.
Both from North 1/4 Corner Section 26



PRIMARY PERMIT 28531

ALL SUPPLEMENTAL
PERMIT 29100

FINAL PROOF SURVEY
UNDER

38323 28581
Application No. 39088 Permit No. 29100
IN NAME OF

FLOYD A. VAUGHAN

Surveyed May 23 1968 by H. J. Ruggans