


1" = 100'

SEE MAP 36 5 21A

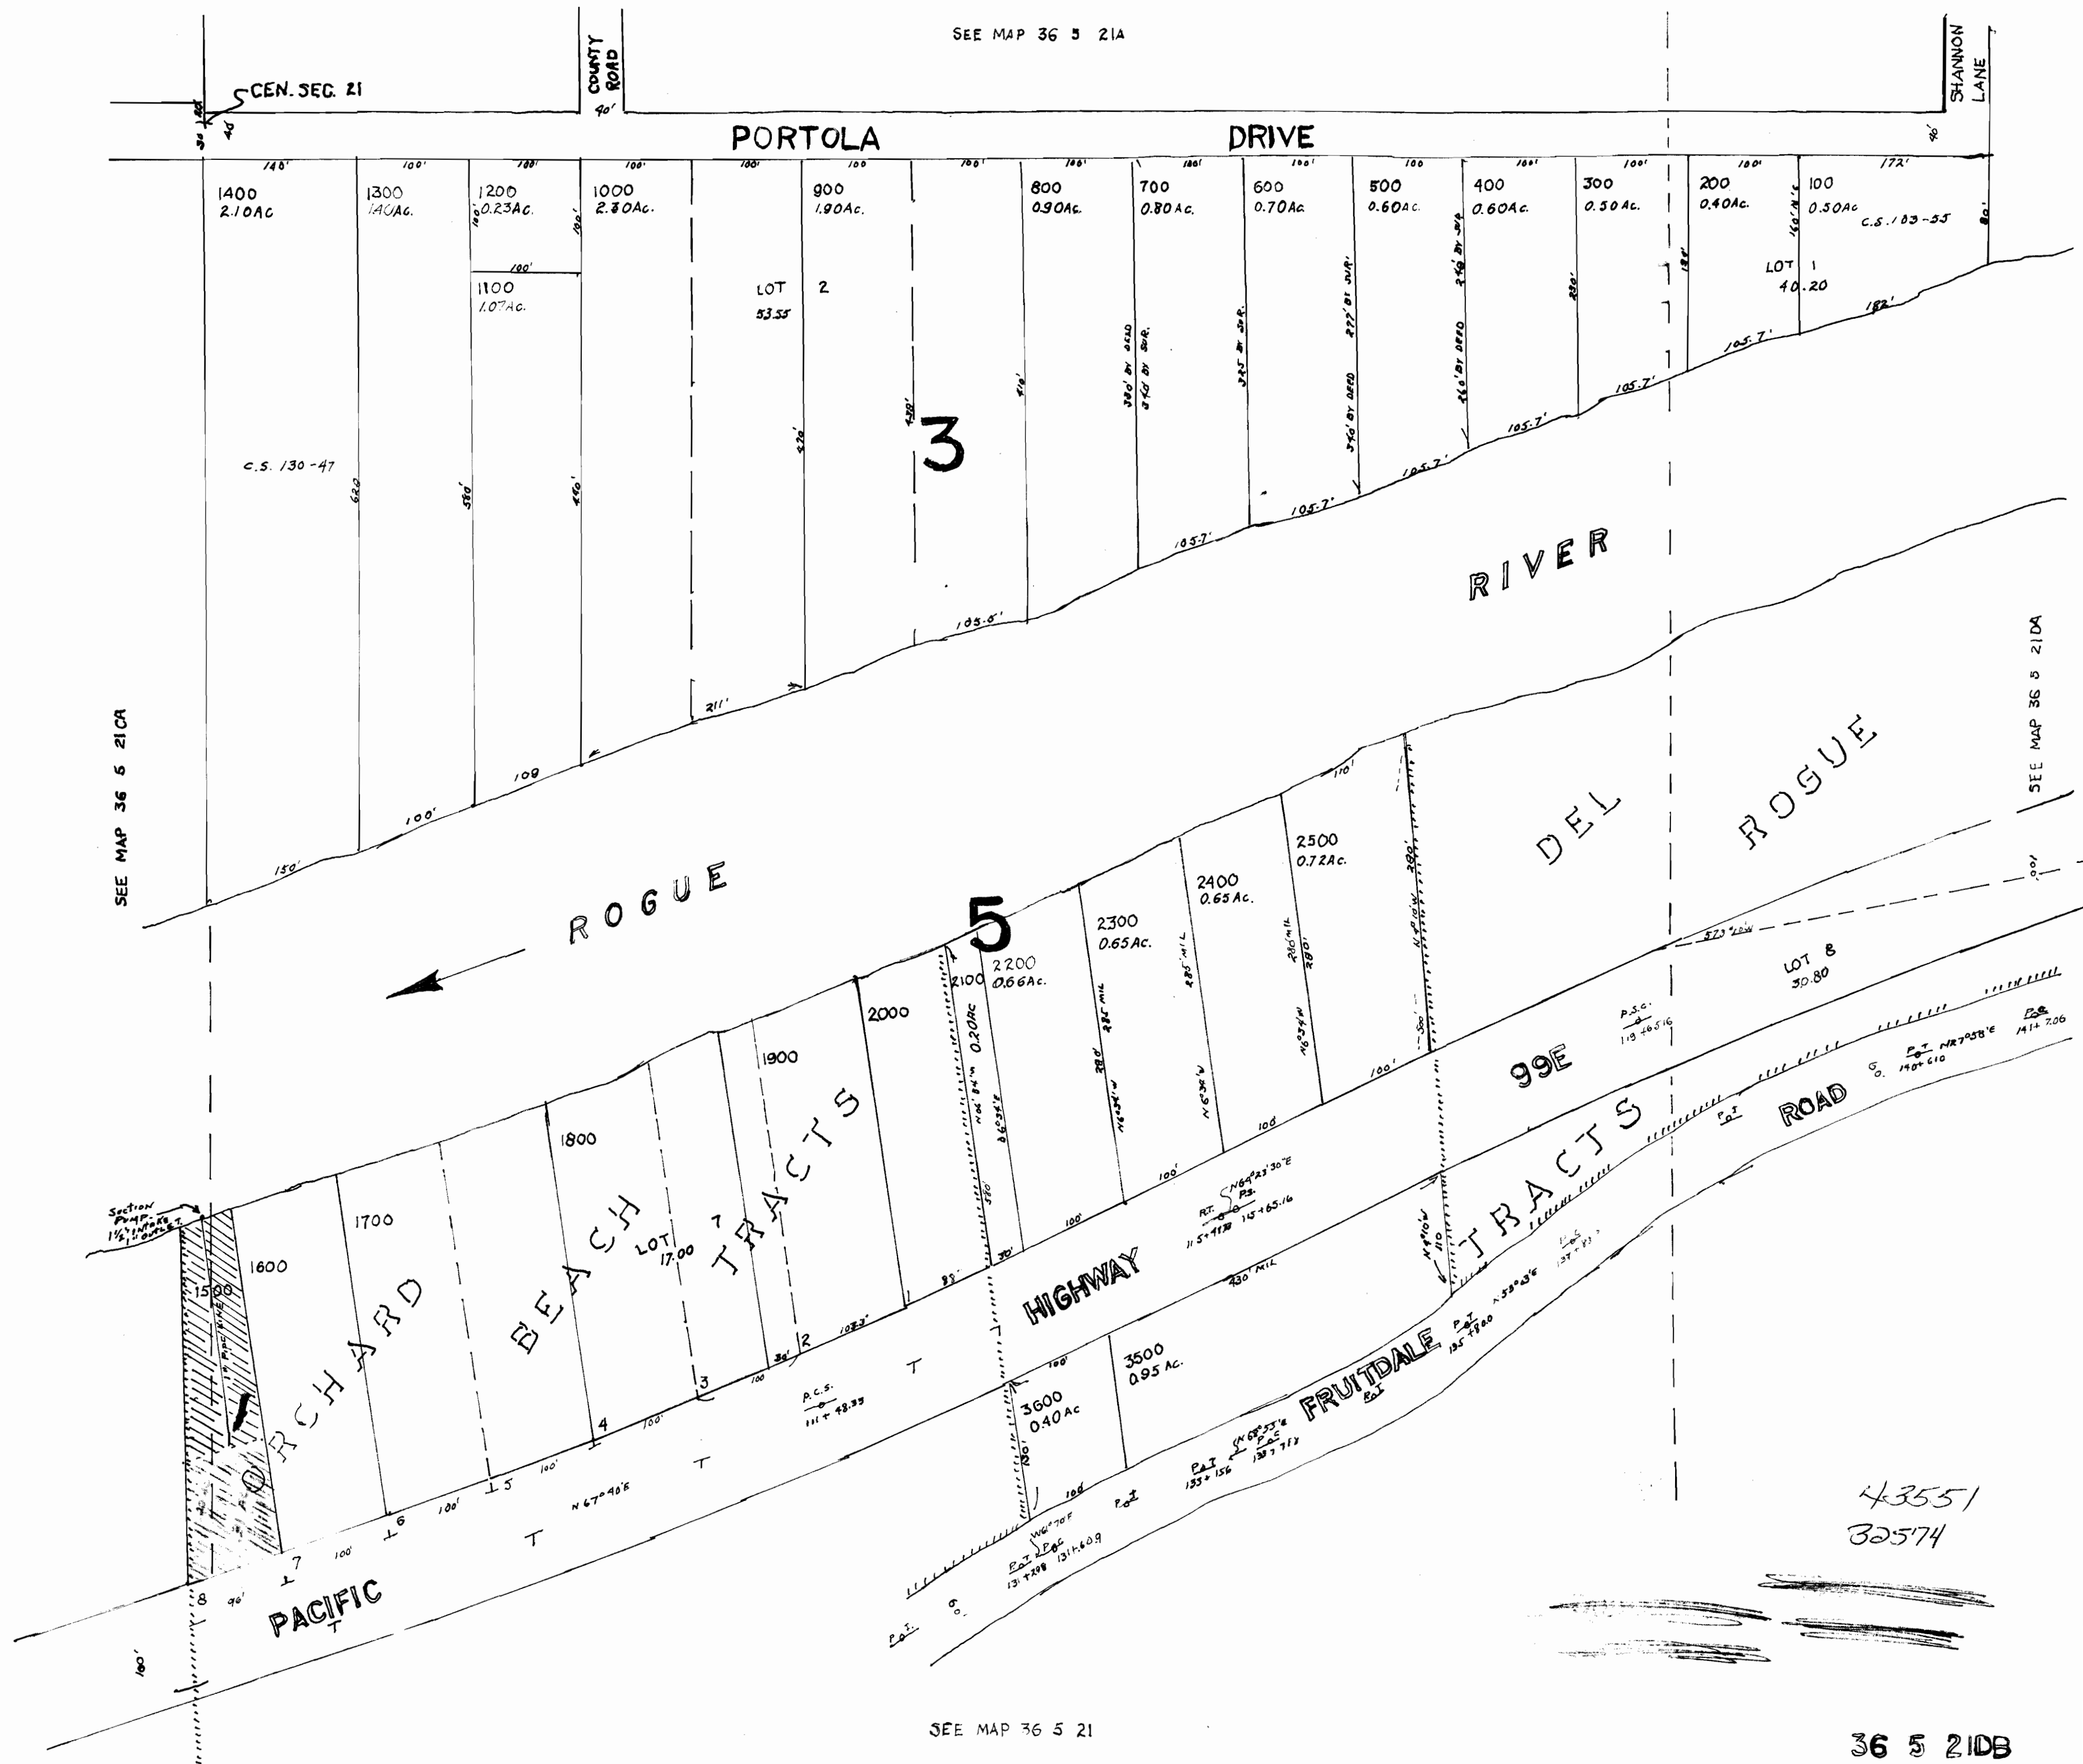

SEE MAP 36 5 21