


T.18S.R.4W.W.M.

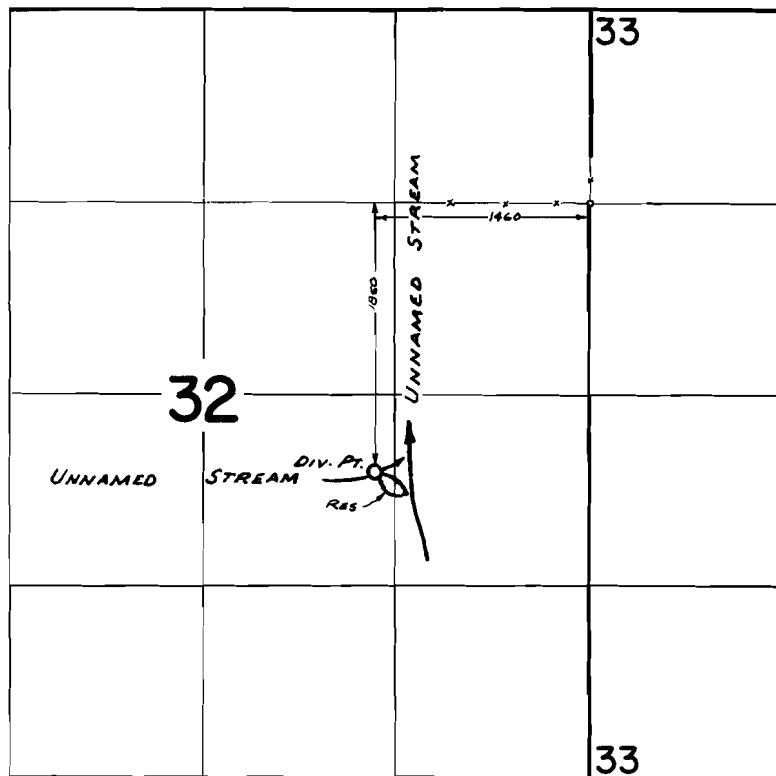

FINAL PROOF SURVEY
UNDER

R-40746 R-4566
Application No. 40961 Permit No. 30427
IN NAME OF

TED E. MARINEAU

Surveyed MAY 1-2 1969, by W. RUPPERT.