


T.20S.R.4 W.W.M.

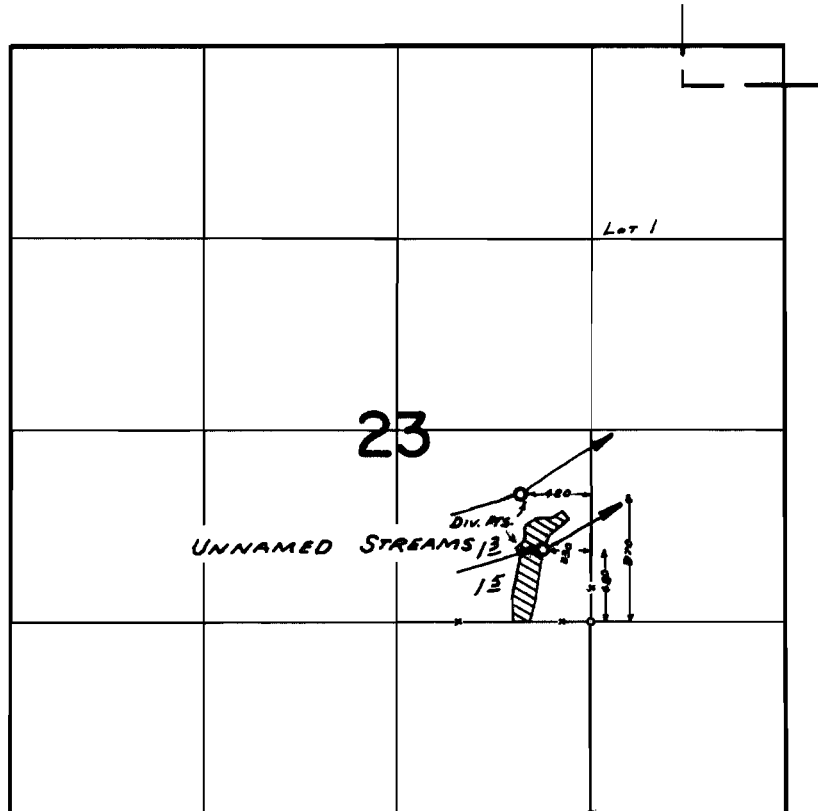

FINAL PROOF SURVEY


UNDER

Application No. 37154 Permit No. 27674
IN NAME OF

ALVA L. FLETCHER

Surveyed APR 29 1969, by W. RUPPERT

T.20S.R.4 W.W.M.

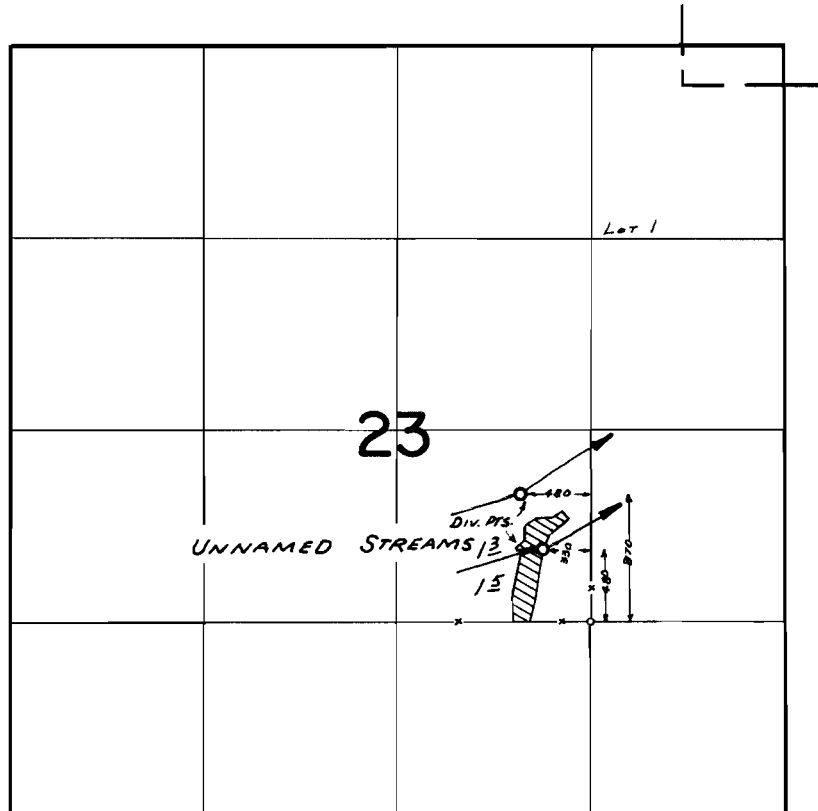

FINAL PROOF SURVEY
UNDER

Application No. 37154 Permit No. 27674
IN NAME OF

ALVA L. FLETCHER

Surveyed APR 29 1969, by W. RUPPERT