


T.18S.R.2E.W.M.

SUPERCEDED

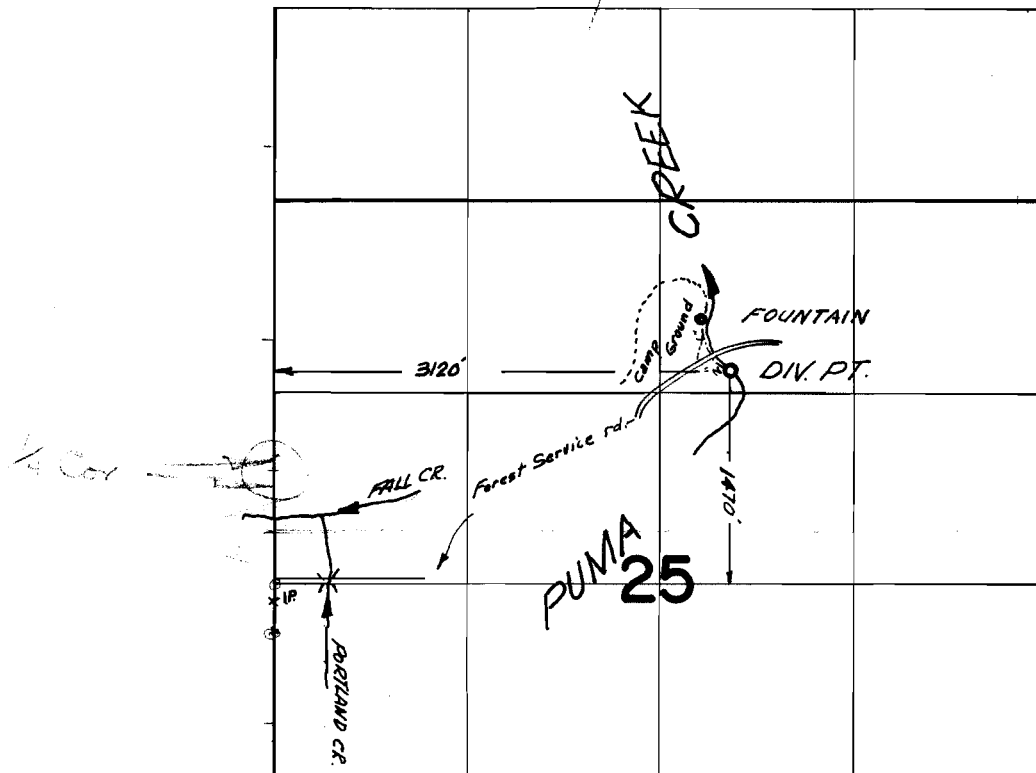

FINAL PROOF SURVEY
UNDER

Application No. 40056 Permit No. 29976
IN NAME OF

U.S. DEPT. OF AGRICULTURE

Surveyed May 9 1966, by V. GARNER