


T.15&16S.R.6W.W.M.

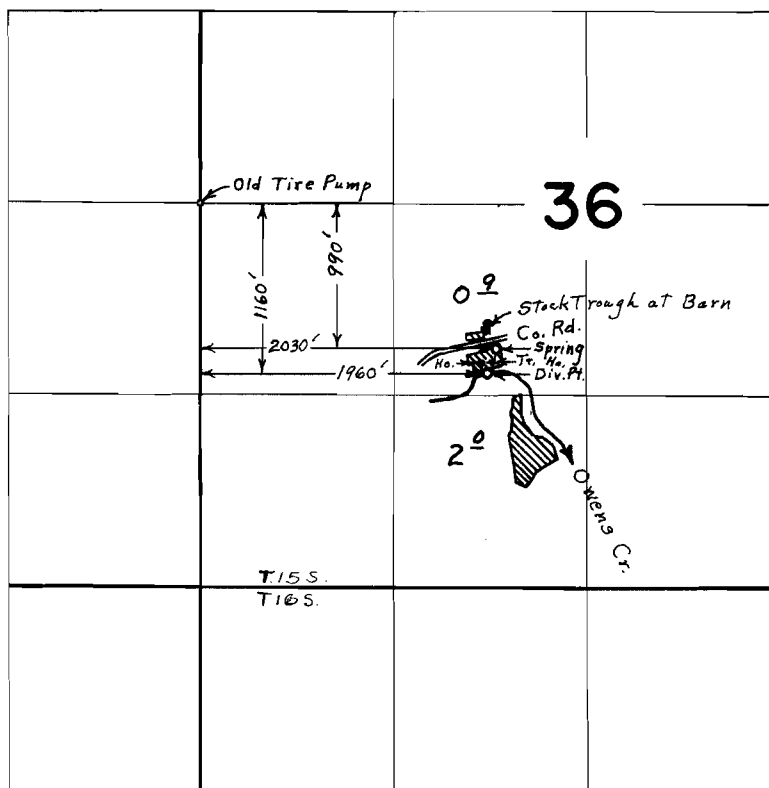

FINAL PROOF SURVEY
UNDER

Application No. 40710 Permit No. 30377
IN NAME OF

WALTER R. & M. MAYRILLA BARROWS

Surveyed May 3, 1967, by L. E. Gould