


T.21S.R.3W.W.M.

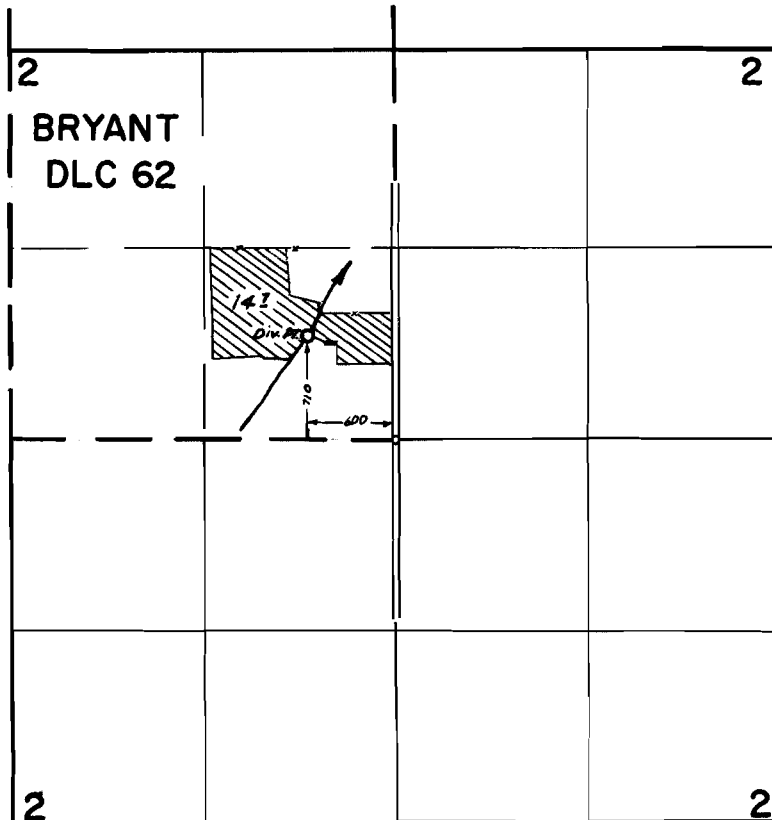

FINAL PROOF SURVEY
UNDER

Application No. 40871 Permit No. 30794
IN NAME OF

DALE W. & JOYCE M. JONES

Surveyed APR. 30, 1969, by W. RUPPERT