


T. 13 & 14 S. R. 1 W. W.M.

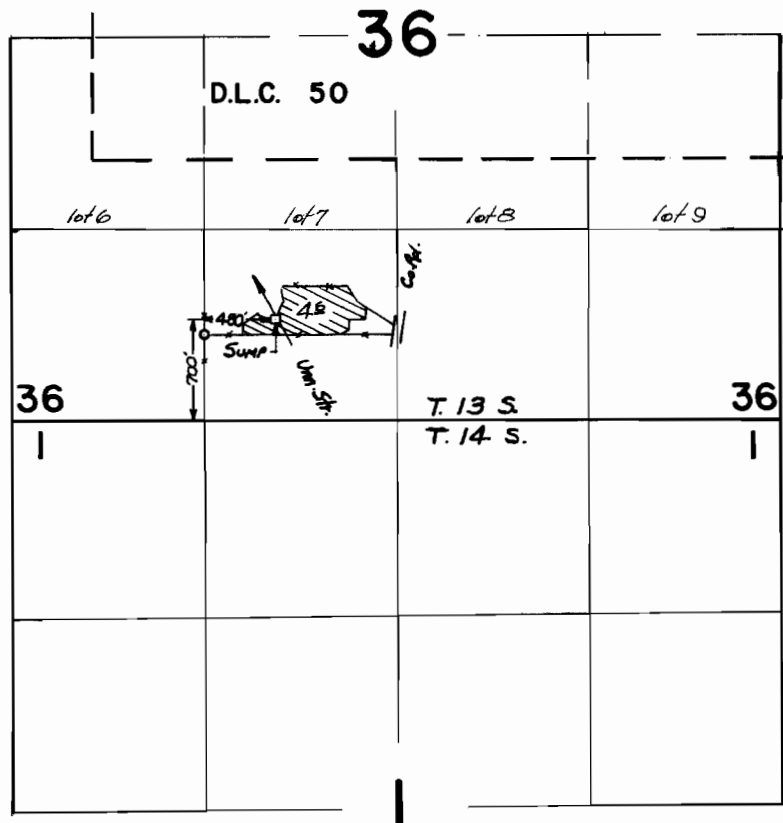

FINAL PROOF SURVEY
UNDER

Application No. G. 3820. Permit No. G. 3462.
IN NAME OF

P. W. WALBERG

Surveyed 3 SEPT. 1969, by W. J. RUPPERT