


T. 18S. R. 46 E. W. M.

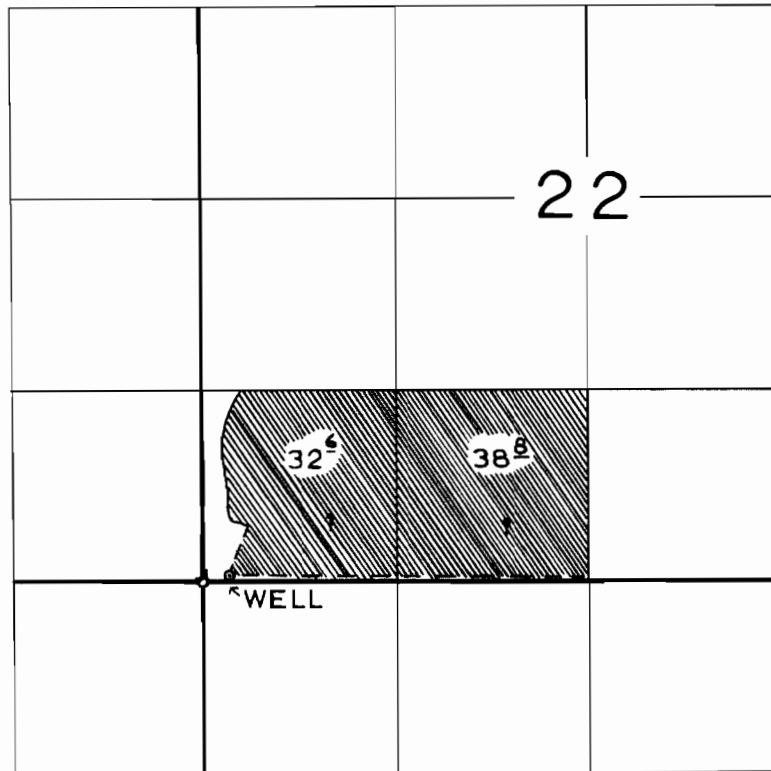

WELL IS 40' N. & 160' E. FROM SW. COR. SEC. 22

FINAL PROOF SURVEY
UNDER

Application No. G-3378... Permit No. G-3178...
IN NAME OF

ROY J. NELSON

Surveyed MAR. 13, 1969, by F. ELFERING