


T.19 S. R.47 E.W.M.

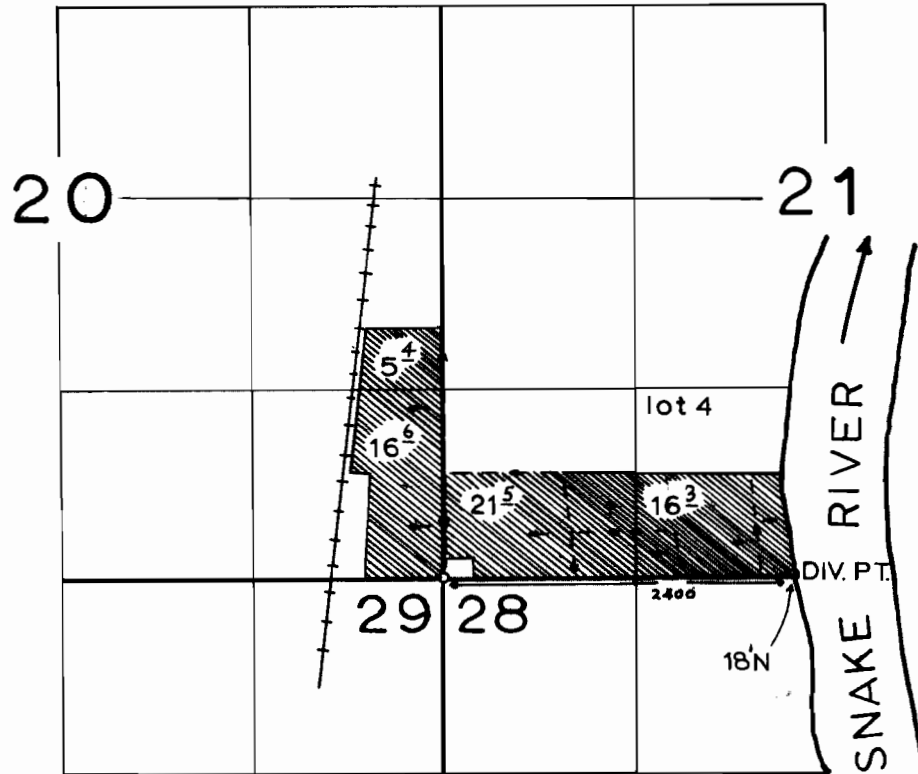

**FINAL PROOF SURVEY**  
UNDER

Application No. 43165 Permit No. 32268  
IN NAME OF

WYATT C. AND HAZEL E. SMITH

Surveyed MAR. 14, 1969, by F. ELFERING