


N.

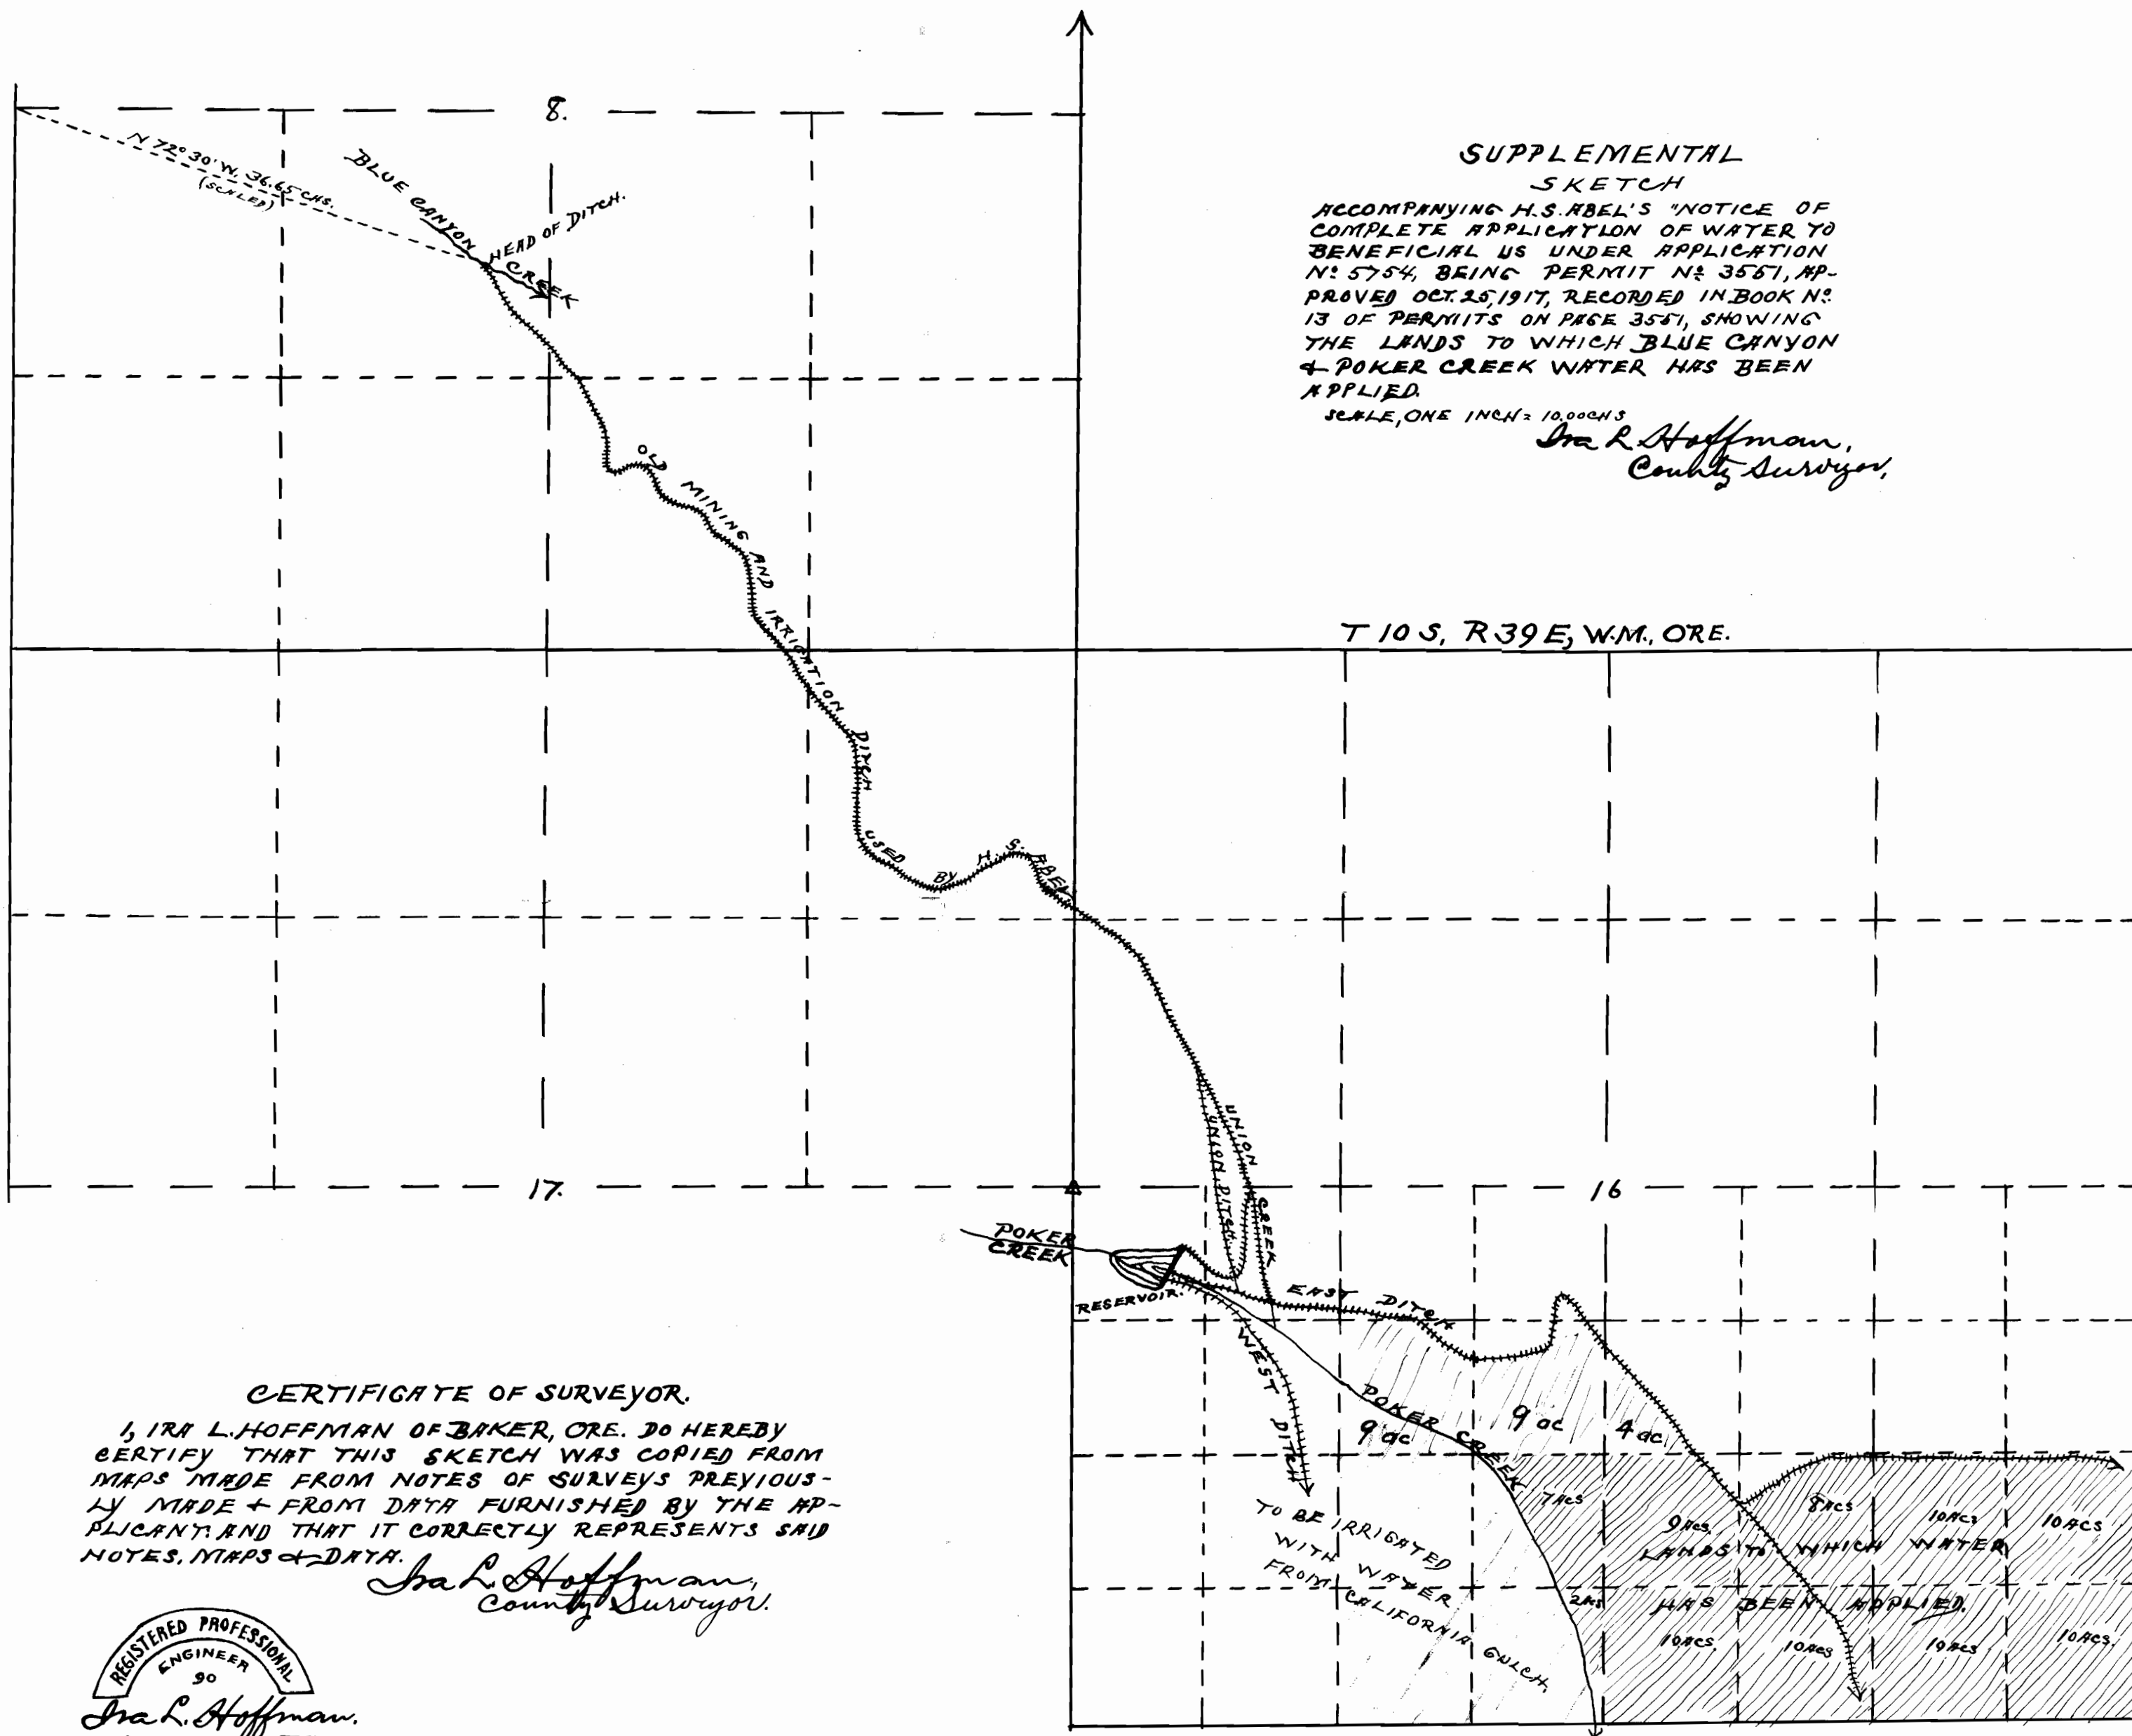

SUPPLEMENTAL SKETCH

ACCOMPANYING H.S. ABEL'S "NOTICE OF COMPLETE APPLICATION OF WATER TO BENEFICIAL USE UNDER APPLICATION N° 5754, BEING PERMIT N° 3551, APPROVED OCT. 25, 1917, RECORDED IN BOOK N° 13 OF PERMITS ON PAGE 3551, SHOWING THE LANDS TO WHICH BLUE CANYON & POKER CREEK WATER HAS BEEN APPLIED.

SCALE, ONE INCH = 10,000 CHS.

Ira L. Hoffman,
County Surveyor.

T 10 S, R 39 E, WM, ORE.

CERTIFICATE OF SURVEYOR.

I, IRA L. HOFFMAN OF BAKER, ORE. DO HEREBY CERTIFY THAT THIS SKETCH WAS COPIED FROM MAPS MADE FROM NOTES OF SURVEYS PREVIOUSLY MADE & FROM DATA FURNISHED BY THE APPLICANT, AND THAT IT CORRECTLY REPRESENTS SAID NOTES, MAPS & DATA.

Ira L. Hoffman,
County Surveyor.

