


T.6S.R.7W.W.M.

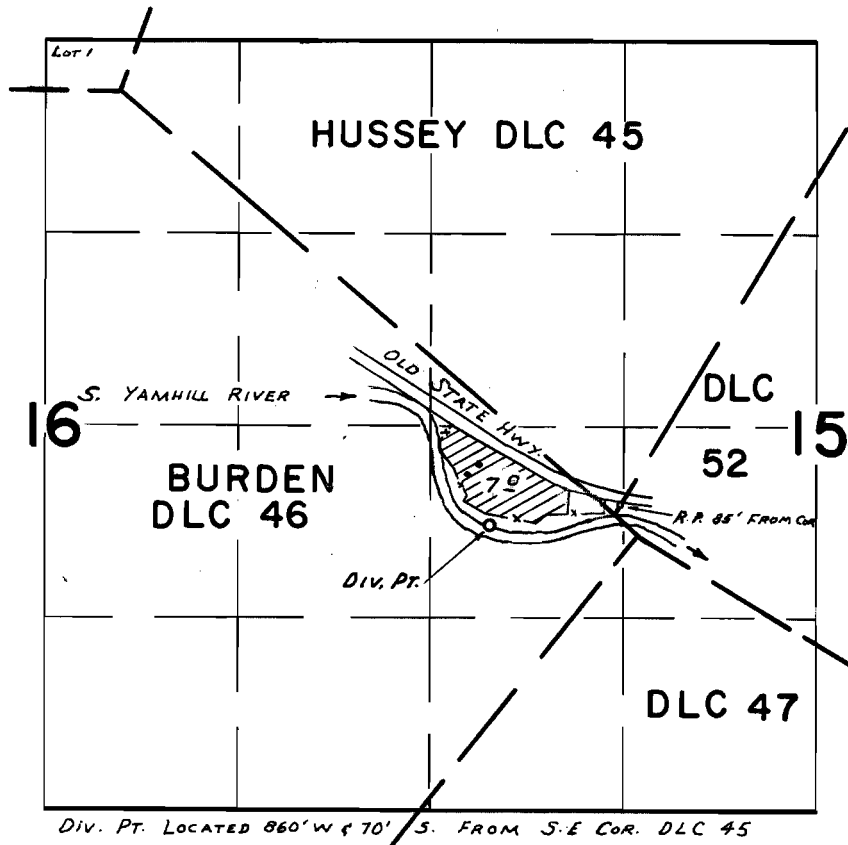

FINAL PROOF SURVEY UNDER

Application No. 43390 Permit No. 32444
IN NAME OF

GORDON & ELEANOR COOKE

Surveyed Nov. 18, 1969, by D. BUELL