


T.9S.R.5W.W.M.

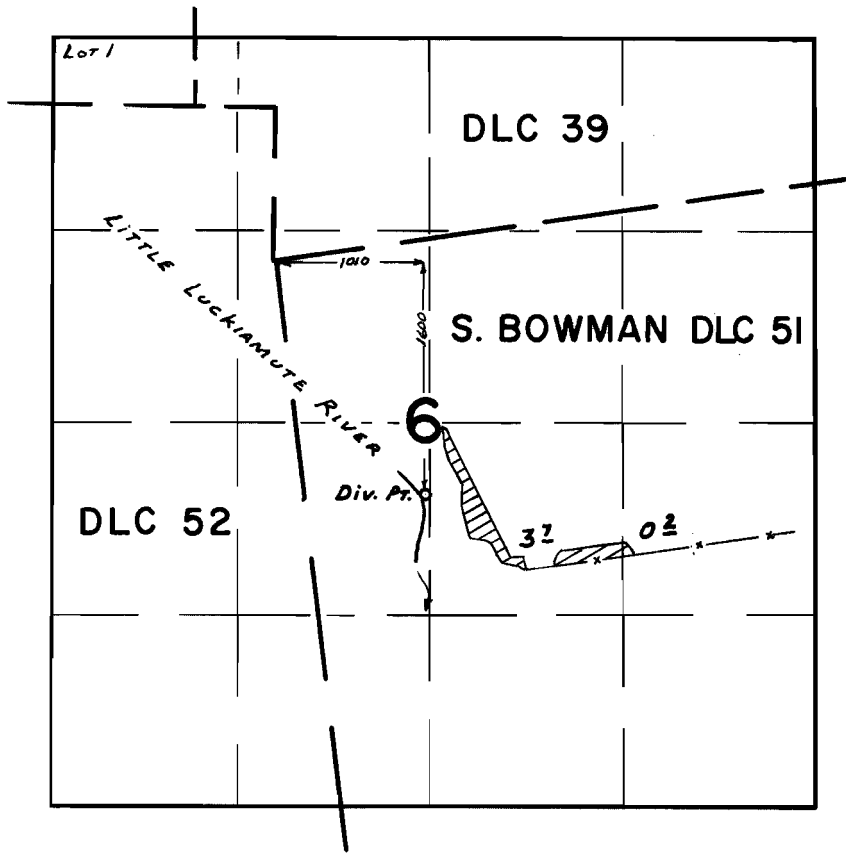

FINAL PROOF SURVEY UNDER

Application No. 44703 Permit No. 33469
IN NAME OF

ALFRED E. MARSHALL

Surveyed Apr. 7, 1969, by D. BUELL