


T. 3 S. R. 40 E. W. M.

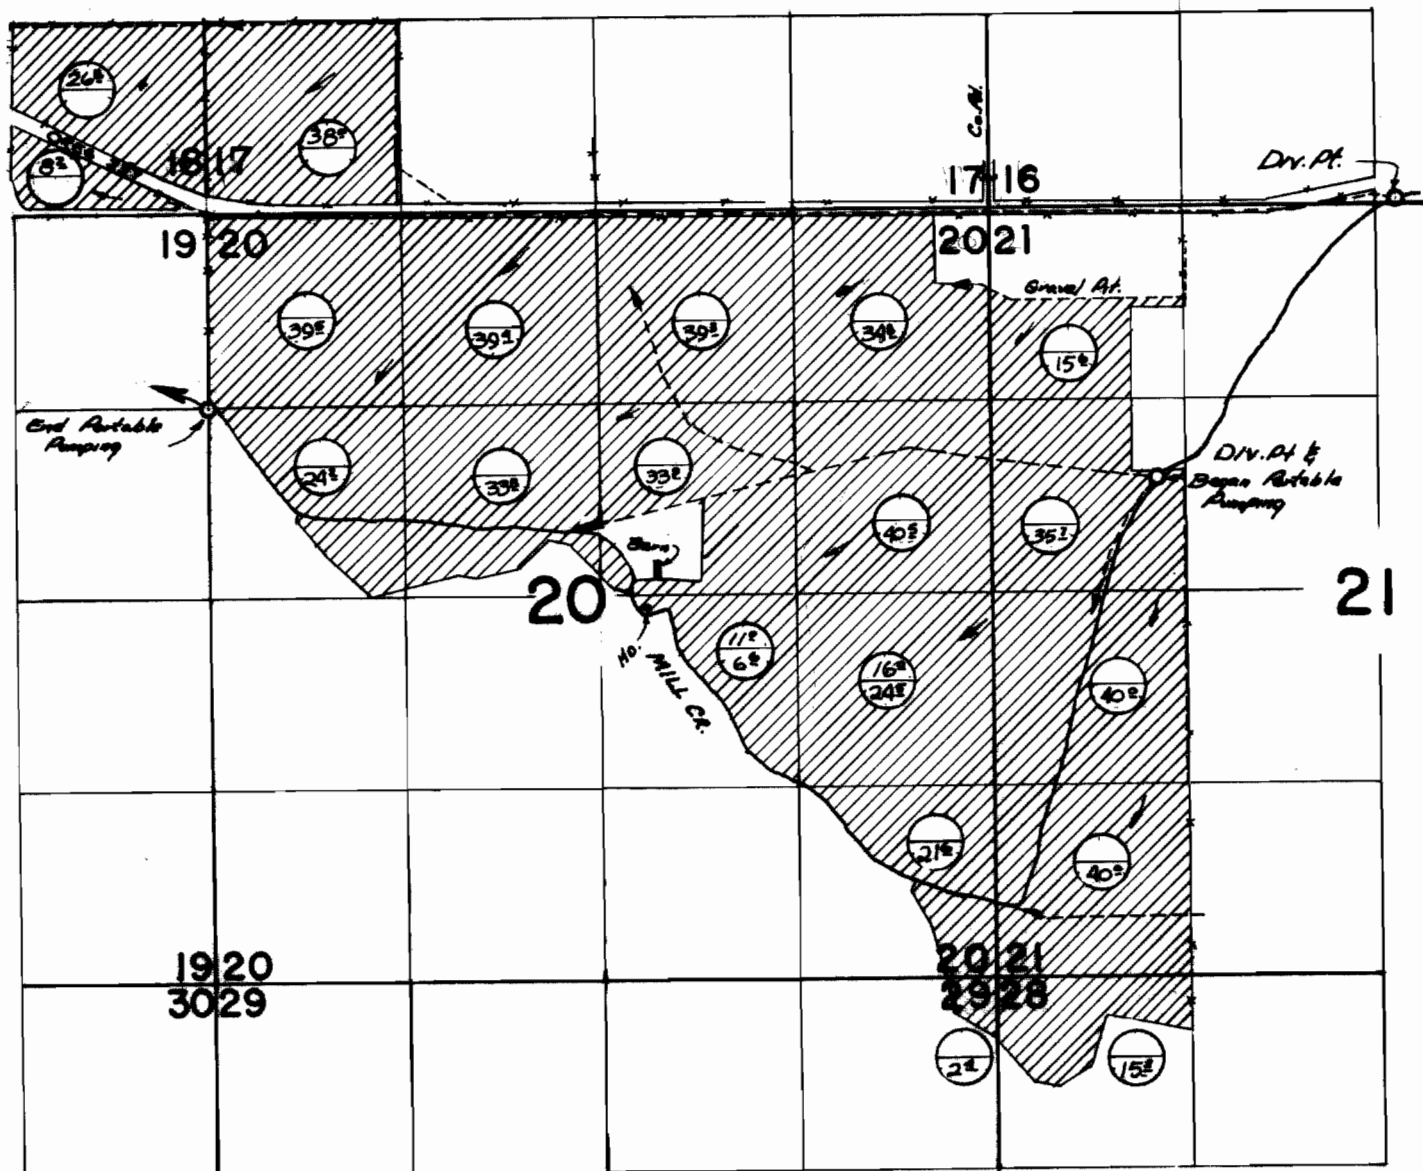

Div. Pt. Located: 40' N & 2700' E, 1870' S & 1130' E, Portable Pumping from 1870' S & 1130' E to 1390' S & 3340' W all from NE 1/4 Cor. Sec. 20.

Supplemental
Primary

FINAL PROOF SURVEY UNDER

Application No. 41175 Permit No. 30728
IN NAME OF

M. M. LEWIS

Surveyed 23 AUG 1969, by W. J. RUPPERT