


T. I N. R. 40 E. W.M.

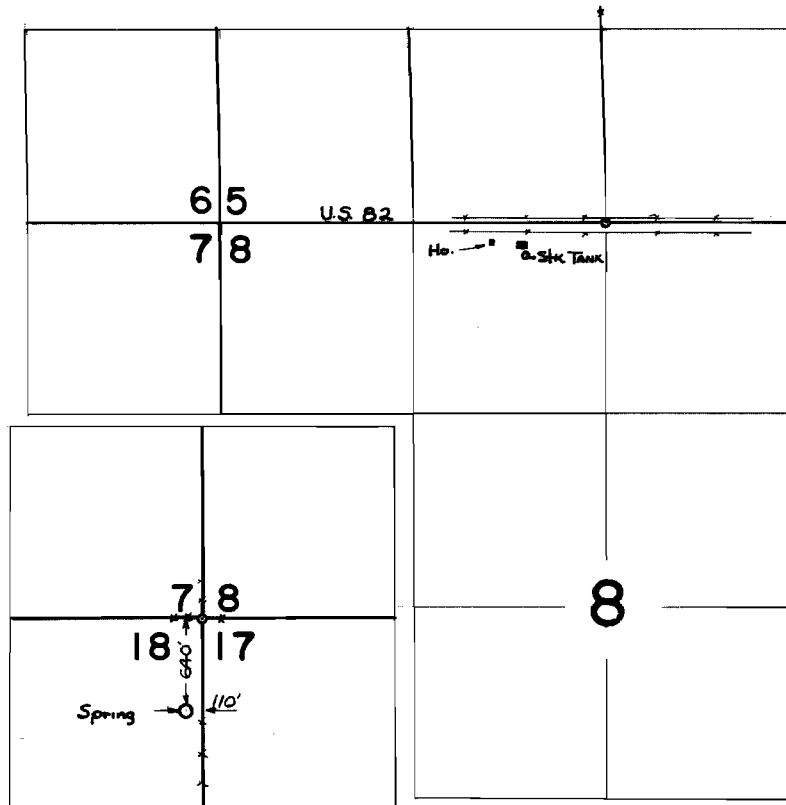

FINAL PROOF SURVEY

UNDER

Application No. 42321 Permit No. 31720
IN NAME OF

HARRY GILLIAM

Surveyed 27 AUG. 1969, by W. J. RUPPERT