


Per. No. 33512  
APP No. 44730

# T. I S. R. 13 E. W. M.

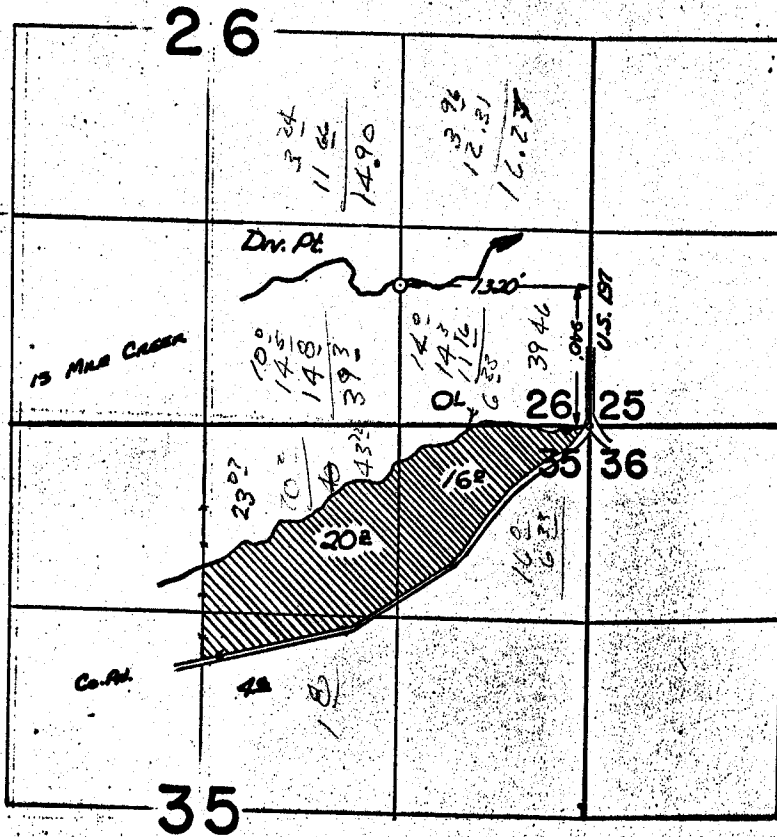

## FINAL PROOF SURVEY UNDER

Application No. 44730... Permit No. 33512...  
IN NAME OF

ROY P. & LOLA E. BARNETT

Surveyed 6 NOV... 1969, by L. E. GOULD...