


T. 9S. R. 40E. W.M.

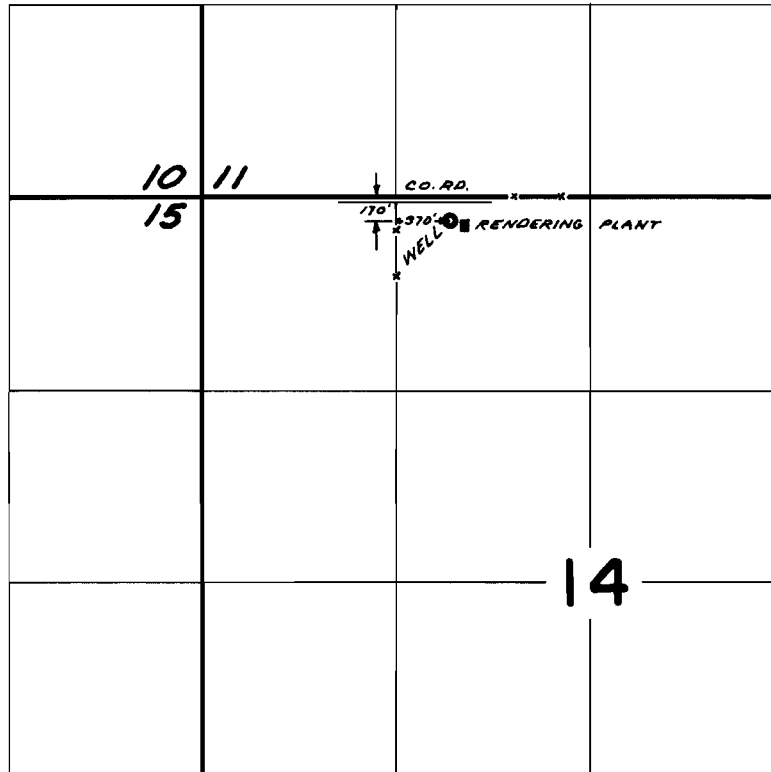

FINAL PROOF SURVEY UNDER

Application No. G-3140 Permit No. G-2934
IN NAME OF

ALVES AND SONS

Surveyed JUL 8 1969, by D. BUELL