


# T. 13 S. R. 4 & 5 W. W. M.

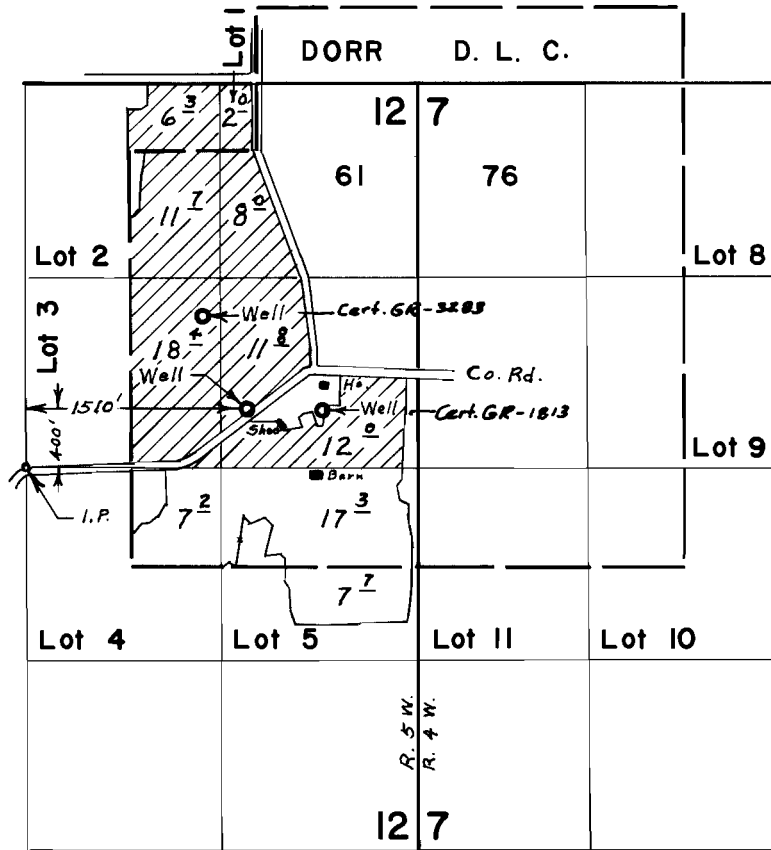

## FINAL PROOF SURVEY UNDER

Application No. G-2924 Permit No. G-2714  
IN NAME OF

**ALEX SMITH**

Surveyed Oct. 30, 1969, by L. E. Gould