


T. 11 S. R. 7 W. W. M. .

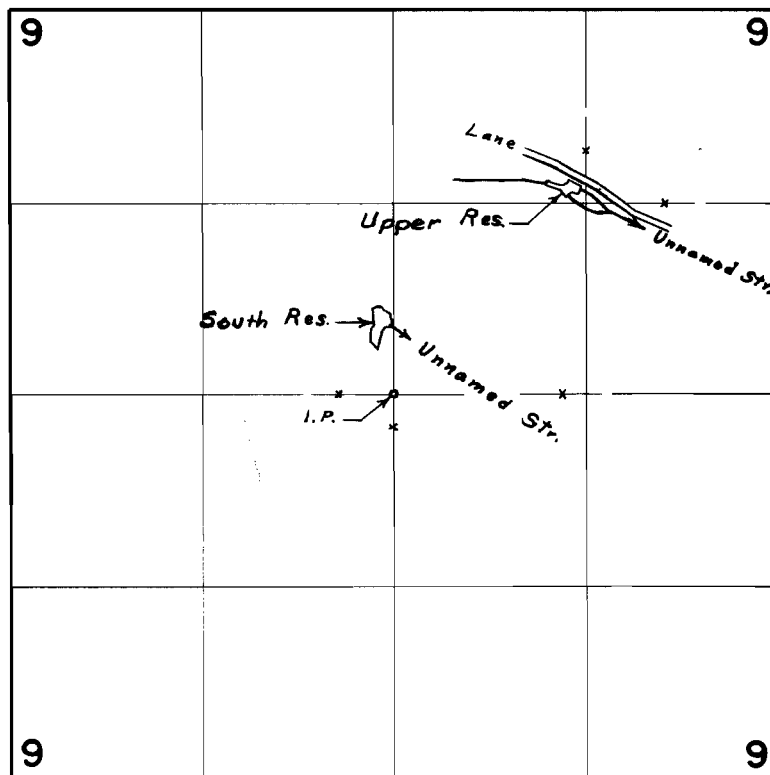

Div. Pts. located; 1400' N. & 1200' E., 470' N. & 20' W., both From Center Sec. 9

FINAL PROOF SURVEY
UNDER

Application No. R-43005 Permit No. R-4886
IN NAME OF
MARVIN CLARK

Surveyed Nov. 10, 1969, by L. E. Gould