T. 11 S. R. 6 W. W. M.

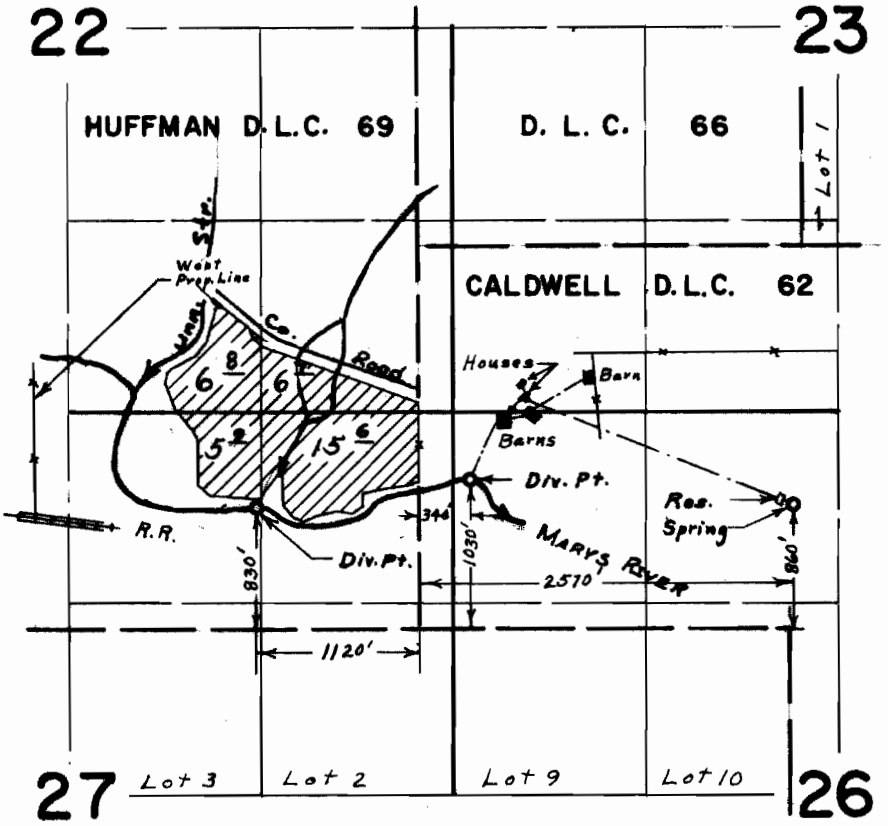

FINAL PROOF SURVEY
UNDER

Application No. 39174 Permit No. 29220
IN NAME OF

ESTATE OF MRS. HARRY J. ANDERSON

Surveyed Aug. 15, 1969, by L. E. Gould

1969-V