


T. 11 S. R. 6 W. W. M.

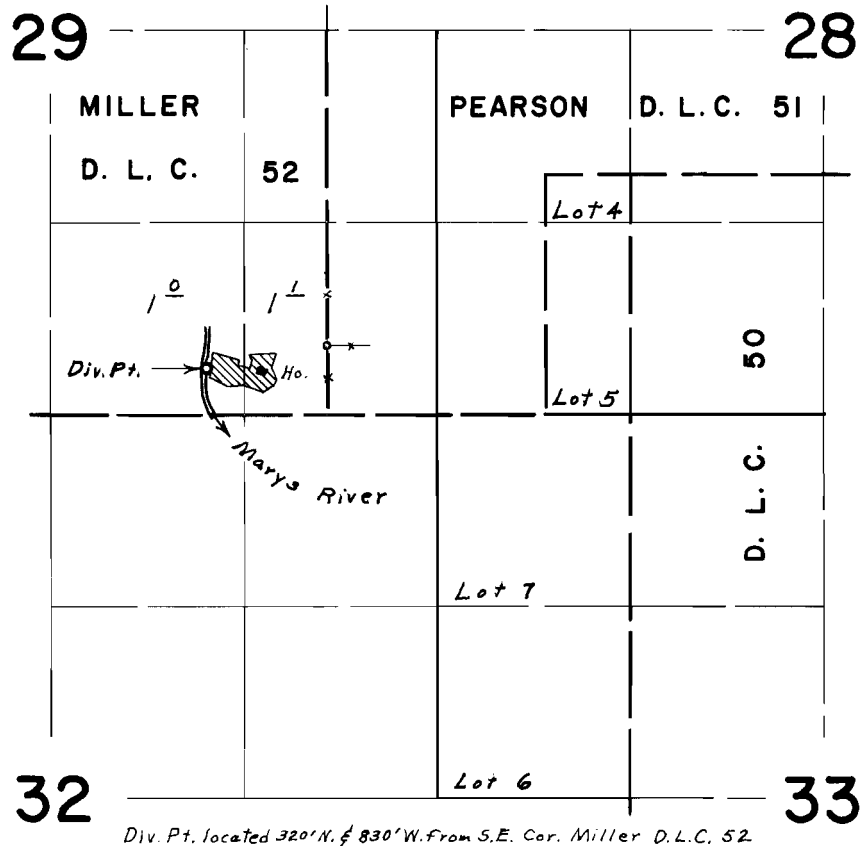

FINAL PROOF SURVEY UNDER

Application No. 43336 Permit No. 32392
IN NAME OF

A. C. TAYLOR

Surveyed Sept. 3, 1969, by L. E. Gould