


T. 10 S. R. 4 W. W. M.

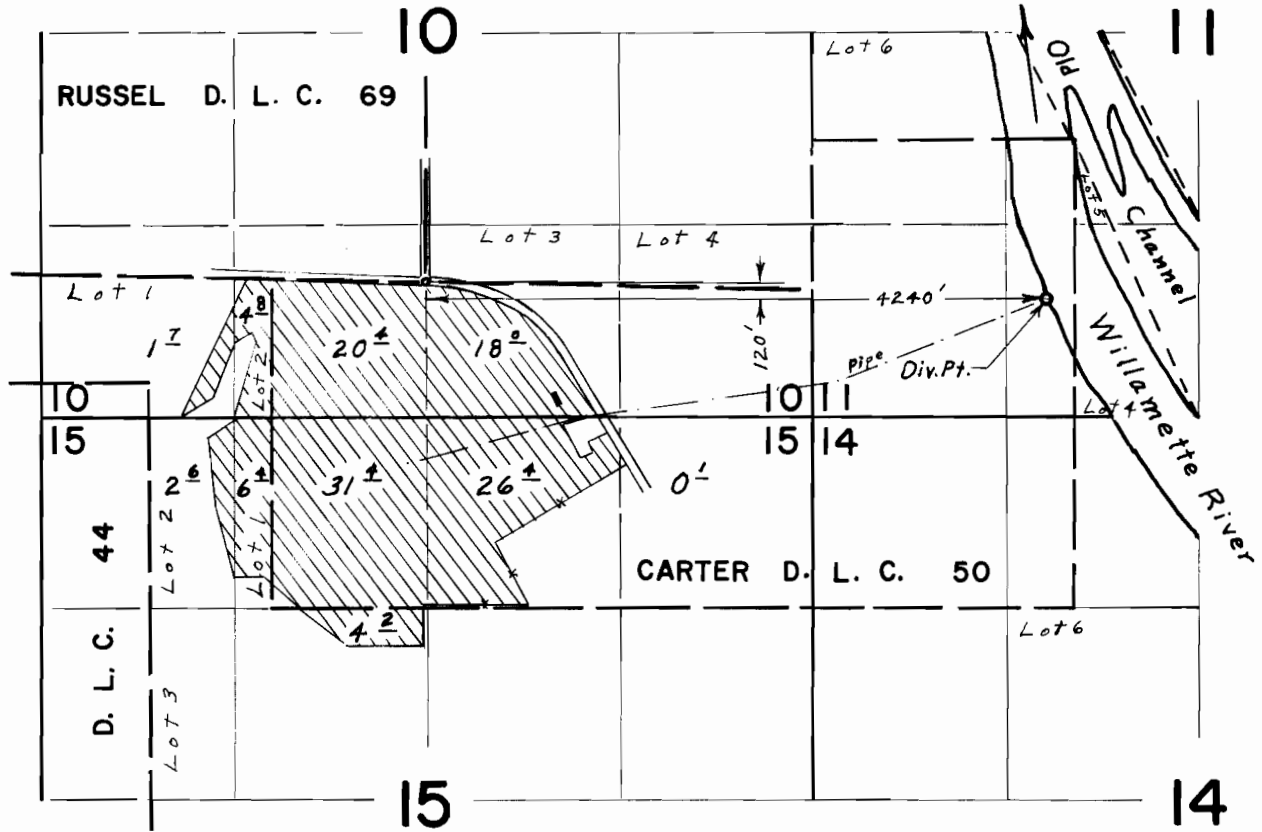

FINAL PROOF SURVEY UNDER

Application No. 43272 Permit No. 32744
IN NAME OF

KENNETH HOLMES

Surveyed May 6, 1969, by L. E. Gould