


T. 12 S. R. 6 W. W. M.

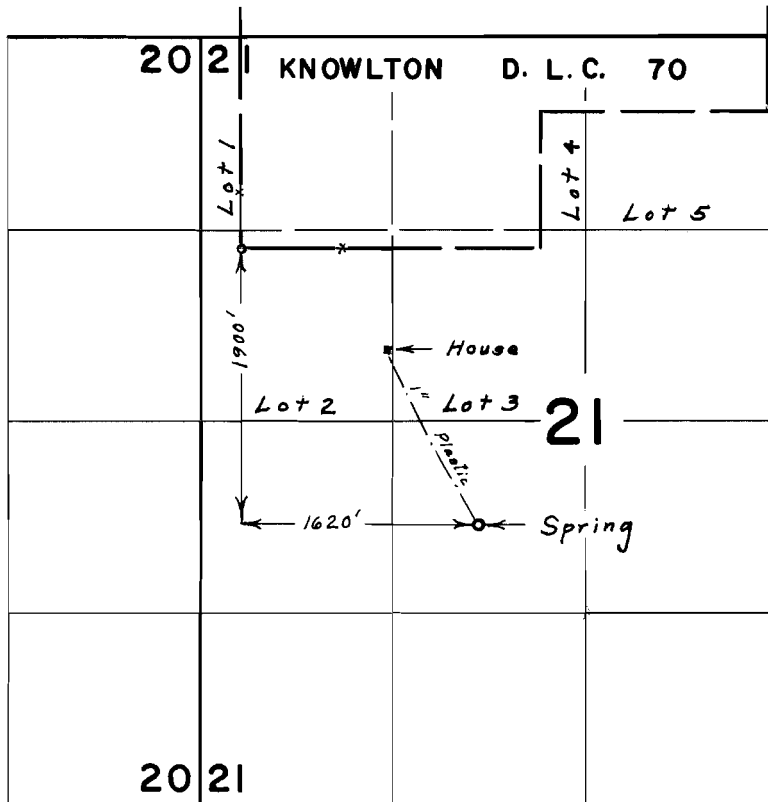

FINAL PROOF SURVEY
UNDER

Application No. 44647 Permit No. 33399
IN NAME OF

MARVIN & LOLA BENNETT

Surveyed June 19, 1969, by L. E. Gould