


T.5S.R.3E.W.M.

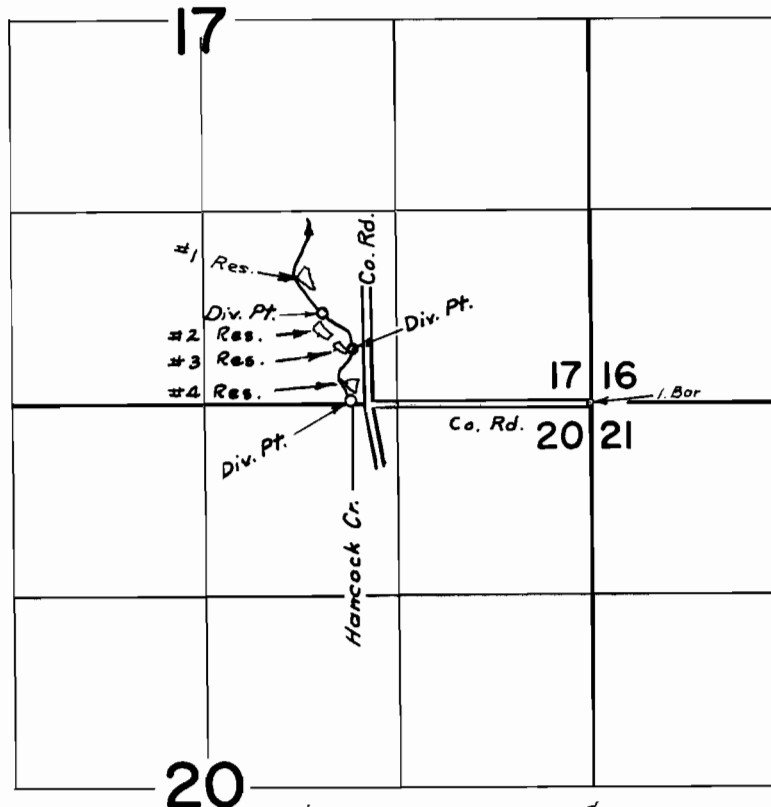

Div. Pts. located: 20 ft. N. & 1640 ft. W.; 380 ft. N. & 1620 ft. W.; and 630 ft. N. & 1830 ft. W.; all from SE cor. Sec. 17.

FINAL PROOF SURVEY
UNDER

42395 31738
Application No. R-42396 Permit No. R-4822
IN NAME OF

AVISON LUMBER CO.

Surveyed Nov. 21 1969, by L. E. Gould