


T. 30 S. R. 11 W. W. M.

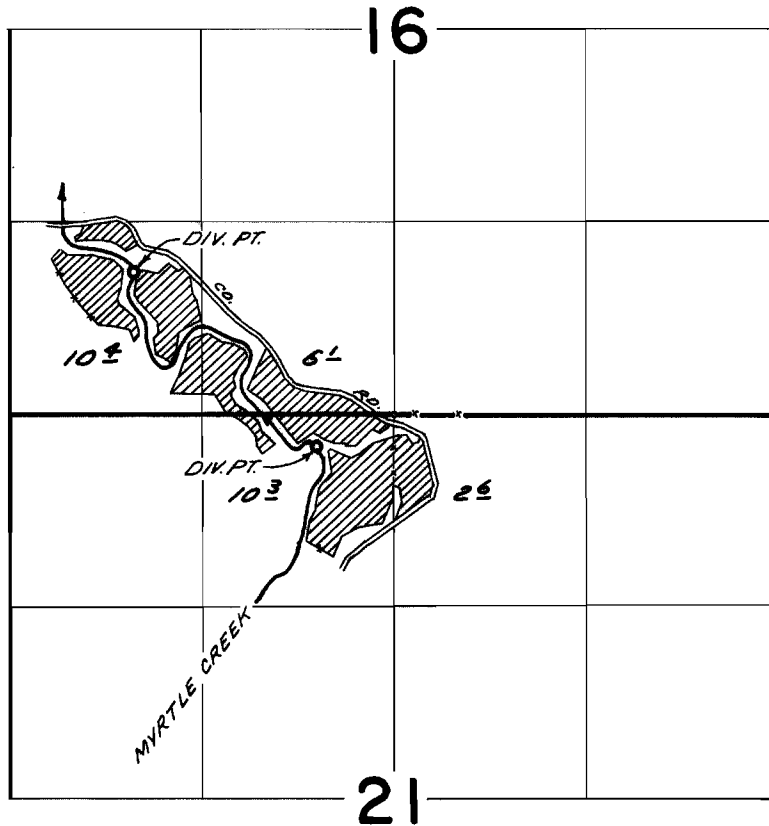

DIV. PTS. LOCATED; 970' N. & 1800' W.; 220' S. & 530' W.;
BOTH FROM N. 1/4 COR. SEC. 21

FINAL PROOF SURVEY
UNDER

Application No. 39398 Permit No. 29290
IN NAME OF

BYRON BIRDWELL

Surveyed AUG. 23 1969, by D. BUELL