


T. 29 S. R. 12 W. W. M.

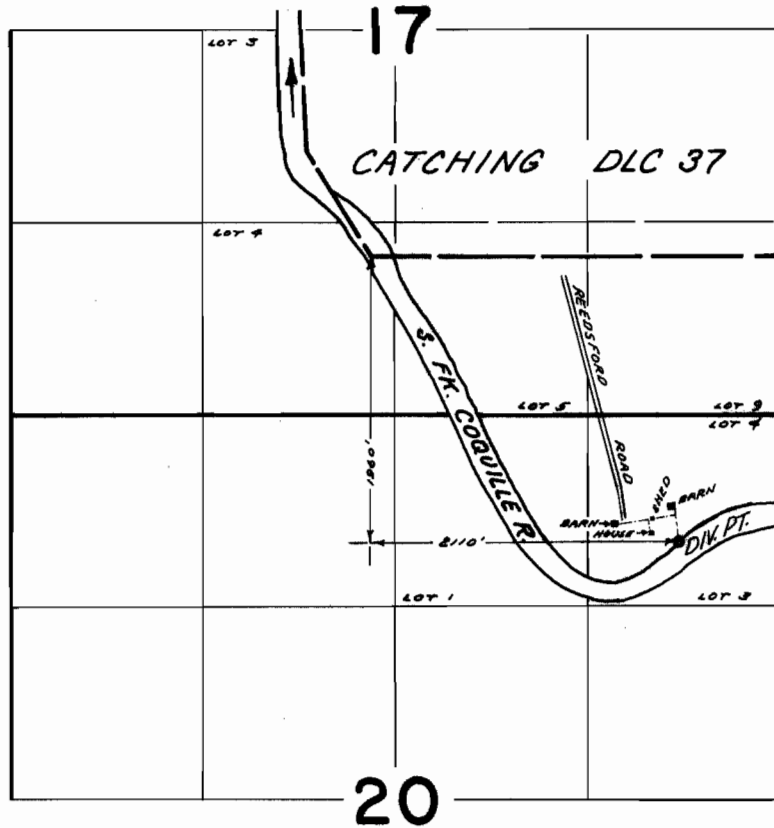

FINAL PROOF SURVEY
UNDER

Application No. 39490 Permit No. 29314
IN NAME OF

EUGENE REED

Surveyed AUG 28 1969, by D. BUELL