


T. 29 & 30 S. R. 11 W. W. M.

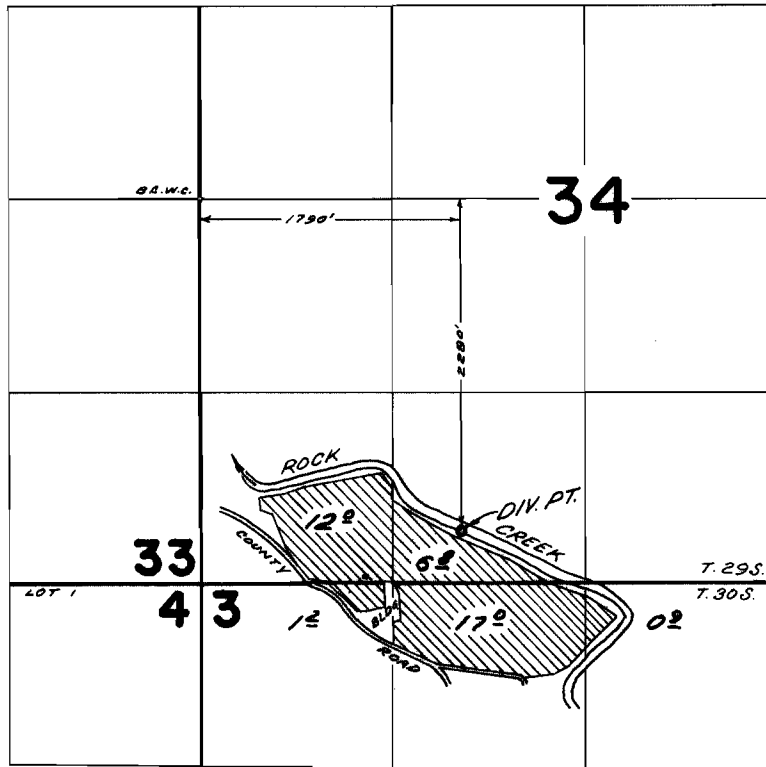

FINAL PROOF SURVEY
UNDER

Application No. 39612 Permit No. 29329
IN NAME OF

ROBERT C. GEANEY

Surveyed SEP 10 1969, by D. BUELL