


T. 28 S. R. 12 W. W.M.

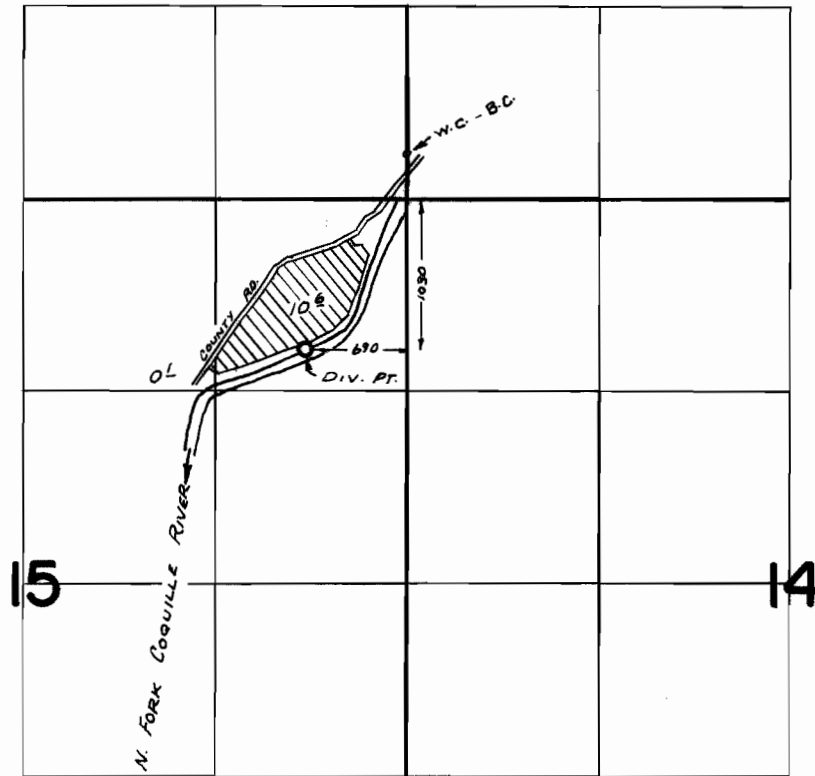

FINAL PROOF SURVEY UNDER

Application No. 39604 Permit No. 29432
IN NAME OF

ARTHUR R. HANNA

Surveyed Aug. 27, 1969, by D. BUELL